

KANSAS

Ellis

Section 12 Township 11 Range 20W

Well No. 1 Warren

Company Sinclair Oil & Gas

No Name

NORTH

WEST

EAST

SOUTH

			0				

2

Sec. 12 Twp. 11 R. 20W

Well No. #1 Warren Farm

Sinclair Oil & Gas Company


No name

330' Ft. from N. Line

_____ Ft. from S. Line

330' Ft. from E. Line

_____ Ft. from W. Line

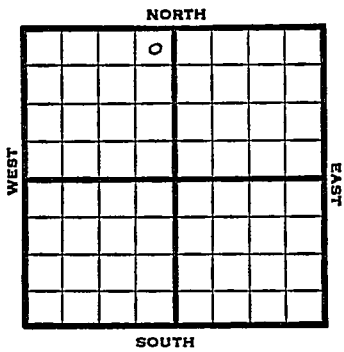

NE NW

1949

Elev 2120' REPORT

- 9/21 Location
- 9/28 "
- 10/5 10" @ 260'
Drlg 2660'
- 10/12 Lansing 3373'
Arb. 3727'
TD 3823'
Runcsg.
- 10/19 Lansing 3360'
Arb. 3721'
TD 3824'
7" @ 3824'
- 10/26 "
- 11/2 TD 3824'
Arb. 3721'
7" @ 3824'
Perf wtr.
Aband.

ABANDONED

Map No. _____ Sec. 12 Twp. 11 R. 20W

Well No. 1 Warren

Sinclair Oil & Gas Company

Contractor

NE NW

FIRST REPORT
SECTION PLAT

330 Ft. from N. Line

_____ Ft. from S. Line

330 Ft. from E. Line

_____ Ft. from W. Line

Ellis County

RECORD

Location X

Rig up

Drilling and Remarks:

Cased _____ in., _____ ft.

Sand _____

Gas _____

Oil _____

Total Depth _____

PRODUCTION

1st 24 hrs. Nat. _____

1st 24 hrs. after shot _____

Gas _____ Cu. Ft.

Dry Hole _____

Abandoned _____

Date

SEP 21 1949 19

S. J. LEWIS Scout

Kansas

Map No. _____ Sec. 12 Twp. 11 R. 20W

Well No. 1 Warren

Sinclair Oil & Gas Company

ABANDONED Contractor

NE NW

E1.2120
SECTION PLAT

330 Ft. from N. Line

_____ Ft. from S. Line

330 Ft. from E. Line

_____ Ft. from W. Line

	0		

Ellis County

RECORD

Location _____

Cased _____ in., _____ ft.

Rig up _____

Sand _____

Drilling and Remarks:

Gas _____

Oil _____

Total Depth 3824

Cor 83721

7" C 3824

1.5M

Prof. Water

PRODUCTION

1st 24 hrs. Nat. _____

1st 24 hrs. after shot _____

Gas _____ Cu. Ft.

Dry Hole _____

Abandoned _____

Date

NOV 2, 1949 19 .

S. J. LEWIS Scout