


Section 12 Township 11 Range 20W

Well No. #1 Warren "A"

Company ~~####~~ K&E Drlg.

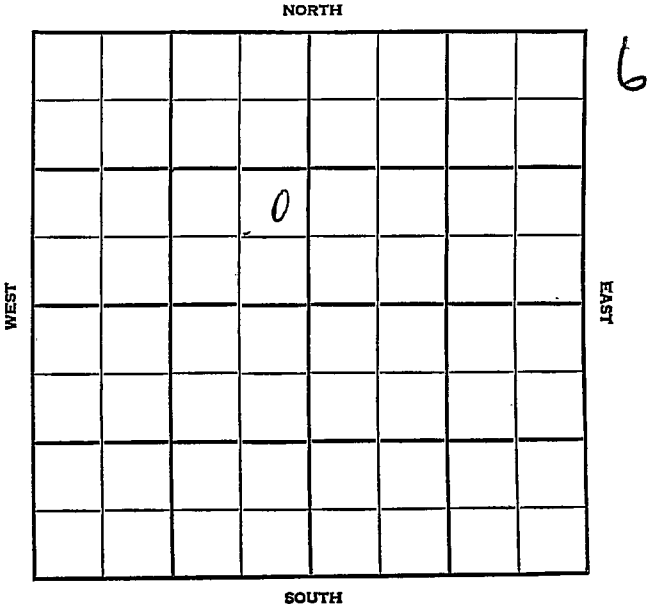

 Sec. 12 Twp. 11 Rge. 20W
 Company K. & E. Drlg.
 Farm Name Warren "A" No. 1

TOPS	DEPTH	LOG	DATUM	Loc. in Sec.
Anh.	1510			NE SE NW
Tr.				
H.				
Tr.				
Dg.				
BL.				
L.				Geol. _____
K.C.				Contr. _____
B.K.C.				Co. Tools
Ce.				Pool
C.				Warren
M.				
M.				
K.				
Mz.				
Me.				
V.				
S.				
S.				
A.				
R.				
Pe.				
G.				
TD.				

Date Comm. 10-4-56

FIRST REPORT

8" @ 209 w/150, Drlg. 2810 OCT 10 '56

2810 + 1 100

2810 + 1 100

FORM 513 SUNRAY

County ELLISElev. 2111 RBSec. 12Twp. 11Rge. 20W

Company

K. & E. Drlg.

FarmName

Warren "A"No. 1

Co.

Lg.

Sec.

T.

R.

R.

TOPS

DEPTH

LOG

DATUM

Loc. in Sec.

Anb.

1510NE SE NW

Tp.

H.

3355

Tr.

3376

Dg.

Bl.

L.

3392

K.C.

B.K.C.

Ce.

C.

3657

M.

M.

K.

Mz.

Mq.

V.

S.

S.

A.

3716

R.

Pe.

G.

TD.

3745

Geol.

Contr.

Co. Tools

Pool.

WarrenOCT 17 560ABANDONEDDate Comm. 10-4-568" @ 209 w/150, Drlg. 2810 OCT 17 56DST 3418-10 1hr 200' MWBITP 1020DEA