


Section 12 Township 11 Range 20W

Well No. #1 Warren "A"

Company Appleman & Derby
Veeder Supply Cont.

NORTH

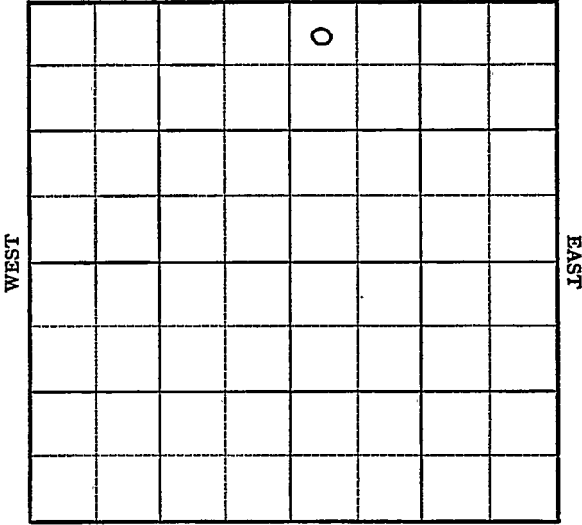

SOUTH

Sec. 12 Twp. 11 R. 20W

Well No. #1 Warren "A" Farm

Appleman & Derby Company


Wildcat (Veeder Supply, Contor)H

330' Ft. from N. Line

_____ Ft. from S. Line

_____ Ft. from E. Line

330' Ft. from W. Line

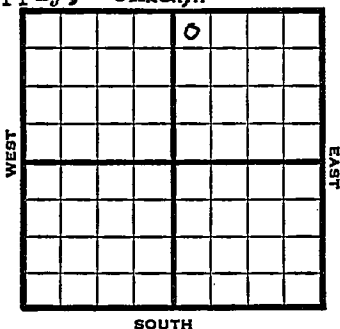

NW NE

SOUTH

1949 Elev. 2142' REPORT

8/17 Location

8/24 8" @ 232
Dr.g 1850

8/31 Lansing 3414'
Drlg. 3466'

9/7 Lans 3409 corrected
Arbuckle 3729'
TD 3800'
5" @ 3735'

9/14 29 shots 3458-65
2500 acid
Swb 26 bbls oil PH SW

9/21 "

10/5 Arb. 3729'
5" @ 3735'
Lans 3409'
Perf Lans.
2500 acid
Pump 390 oil / 36% W
Pot
30⁵ Grav.
TD 3800'

Comp. **COMPLETED**

Map No. _____ Sec. 12 Twp. 11 R. 20W

Well No. 1 Warren "A"

Appleman & Derby Company

Veeder Supply Contractor

NW NE

FIRST REPORT
SECTION FLAT

330 Ft. from N. Line

_____ Ft. from S. Line

_____ Ft. from E. Line

330 Ft. from W. Line

Ellis County

Location X

Rig up _____

Drilling and Remarks:

RECORD

Cased _____ in., _____ ft.

Sand _____

Gas _____

Oil _____

Total Depth _____

PRODUCTION

1st 24 hrs. Nat. _____

1st 24 hrs. after shot _____

Gas _____ Cu. Ft.

Dry Hole _____

Abandoned _____

Date

AUG 17 1949 19

S. I. LEWIS Scout

Kansas

Map No. _____ Sec. 12 Twp. 11 R. 20W

Well No. 1 Warren "A"

Appleman & Derby Company

COMPLETE Contractor

NW NE

21.2142
SECTION PLAT

330 Ft. from N. Line

_____ Ft. from S. Line

_____ Ft. from E. Line

330 Ft. from W. Line

		o	

Ellis County

Location _____

Rig up _____

Drilling and Remarks:

*Cor 82728**5" C 3735**Lins 3409**Perf. Lins**2500 acid**Pump 350 oil + 36% W**Perf*

RECORD

Cased _____ in., _____ ft.

Sand _____

Gas _____

Oil _____

Total Depth *3700*

PRODUCTION

1st 24 hrs. Nat. _____

1st 24 hrs. after shot _____

Gas _____ Cu. Ft.

Dry Hole _____

Abandoned _____

Date

OCT 5

1949

19

S. J. LEWIS

Scout