


Trego

KANSAS

Section 12 Township 11 Range 21W

Well No. #1 Walz

Company Peel & Hardman

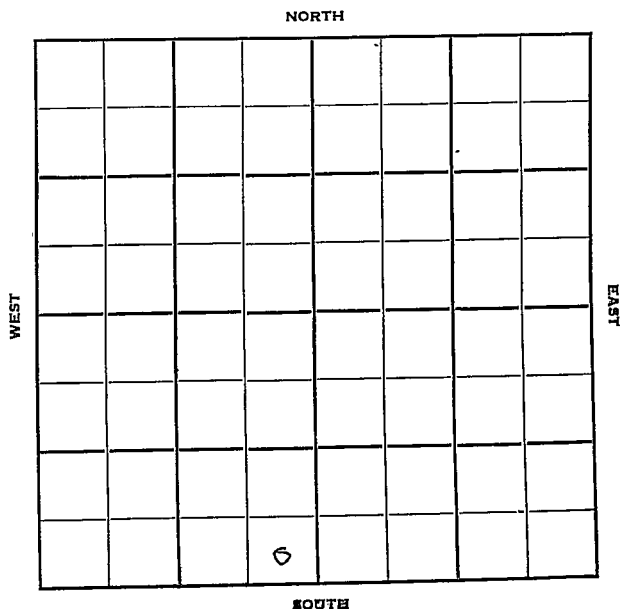

Trego

KANSAS

Sec. 12 Twp. 1E R. 21W ✓

Well No. #1 Walz Farm

Peel & Hardman Company

Peel Drlg. - Contr. Contractor

Wildcat


 Ft. from N. Line

330' Ft. from S. Line

330' Ft. from E. Line

 Ft. from W. Line

SE SE SW

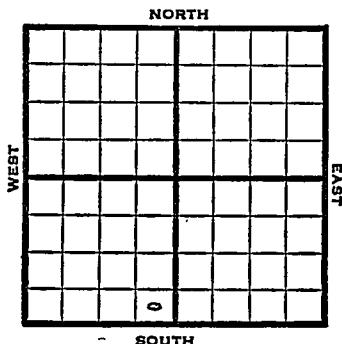


1950 Elev. 2094' REPORT

10/18 Drlg.
12/6 Oil Well TD 3680
8" @ 170' Anhy 1538-85 Heeb 3334'
Lans. 3371'
DST 3454-63 opn 15 min
Rec. 800' sw
DST 3520-66 opn 45 min
Rec. 60' socm Arb. 3666'
TD 3671 5" @ 3668 DD 3675
B/4 goph 300A B/1½ boph DD 3680
S/2 boph 750 A
S/24 boph P/290 bopd
Comp. 397 bopd.

COMPLETED

J. E. TYRA

County Trego State Kansas
 Sec. 12 (Blk. 11 (Sur. 21W Map No.
 (Twp.) (Rgs.)
 Operator Peel & Hardman
 Well No. 1 Farm Walz
 Elev. 2094 Location SE SE SW

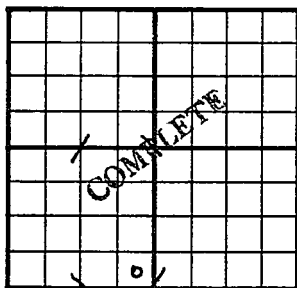

330 Ft. From S Line SW
330 Ft. From E Line Quarter

1st. Report

Completion DEC 6 1950

Remarks Wildcat

Peel Drlg. - Contr.

Spudding Date

Drlg. Data Oil well TD 3680

8" @ 170 Anhy 1538-85 Heeb. 3334

Lans. 3371 DST 3454-63 open-15 min.

Rec. 800' sw DST 3520-66 open 45 min.

Rec. 60' socm Arb. 3666 TD 3671 5" @

3668 DD 3675 B/ 4 goph 300' A

B/ 1 $\frac{1}{2}$ boph DD 3680 S/ 2 boph 750. A

S/ 24 boph P/ 290 bopd Comp., 397 bopd

J. E. TYRA