


Section 12 Township 11 Range 21WWell No. #1 H. WalzCompany Magnolia

NORTH

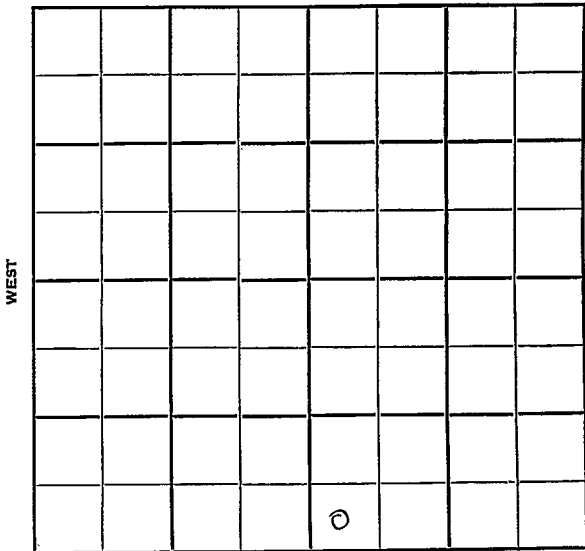

Trego

KANSAS

Sec. 12 Twp. 11 R. 21W

Well No. #1 H. Walz Farm

Magnolia Company

Barnett Drlg. - Contr. Contractor

Walz Pool


Ft. from N. Line

330' Ft. from S. Line

Ft. from E. Line

330' Ft. from W. Line

SW SW SE

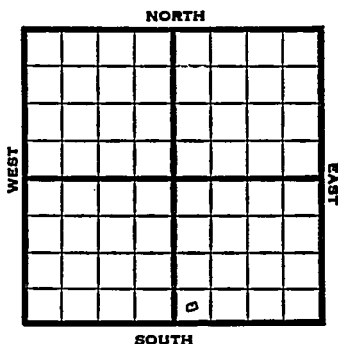


1950 Elev. 2086' REPORT

12/20 Spud 12-15-50
8" @ 206'
Drlg. 1920'

1951
1/17 Spud 12-15-50
Oil Well TD 3671
8" @ 206' Heeb. 3330' Lans. 3363
DST 3521-62 opn 15 min
Rec. 30' mud w/SSO & gas
DST 3563-78 opn 50 min
Rec. 25' sw Arb. 3658-63
5" @ 3660 TD 3668'
S/1/2 boph 500 A no inc.
TD 3671 S/2 boph 1000 A S/6 boph
Comp. 124 bopd 4% wtr.

COMPLETED

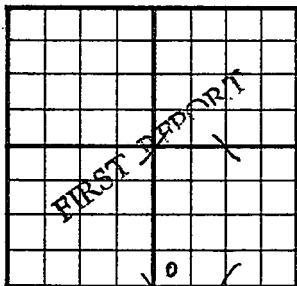
County Trego State KansasSec. 12 (Blk. Twp.) 11 (Sur. Rge.) 21W Map No.Operator MagnoliaWell No. 1 Farm H. WalzElev. Location SW SW SE330 Ft. From S Line SE330 Ft. From W Line Quarter1st. Report DEC 20 1950

Completion

Remarks

Barnett Drig. - Contr.Spudding Date 12-15-50Drig. Data Walz Pool8" @ 206 drig. 1920

J. E. TYRA

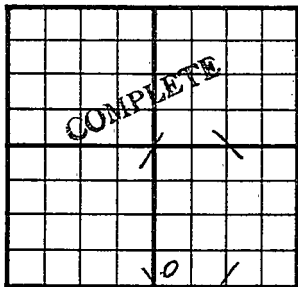County Trego State KansasSec. 12 (^{Blk.}_{Twp.}) 11 (^{Sur.}_{Rge.}) 21W Map No.Operator MagnoliaWell No. 1 Farm H. WalzElev. 2086 Location SW SW SE330 Ft. From S Line SE330 Ft. From W Line Quarter

1st. Report

Completion JAN 17 1951Remarks Walz PoolBarnett Drlg. - Contr.Spudding Date 12-15-50Drlg. Data Oil well TD 36718" @ 206 Heeb. 3330 Lans. 3363DST 3521-62 open 15 min. Rec. 30' mudw/ SSO & gas DST 3563-78 open 50 min.Rec. 25' sw Arb. 3658-63 5" @ 3660TD 3668 S/ $\frac{1}{2}$ boph 500 A no inc.DD 3671 S/ 2 boph 1000 A S/ 6 bophComp. 124 bopd 4% water