

Trego


KANSAS

SECTION 12 TOWNSHIP 11 RANGE 21 W

WELL NO. # 1 Walz

COMPANY Imperial

NORTH SE SE NW

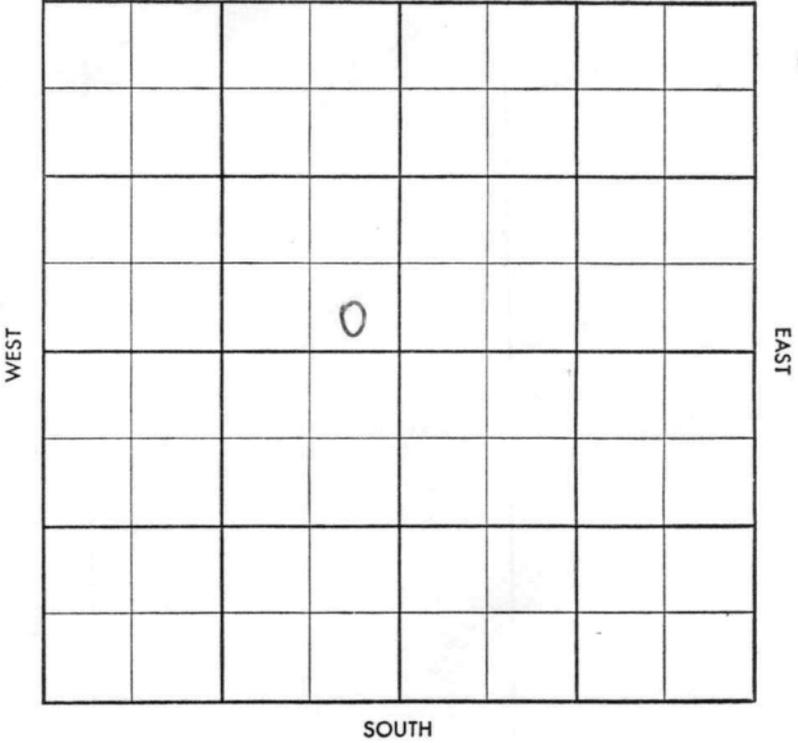

~~Imperial Petroleum~~  
~~Imperial Petroleum~~

County Trego Elev. \_\_\_\_\_

Sec. 12 Twp. 11 Rge. 21W

Company Imperial

Farm Name Walz No. 1

TOPS	DEPTH	LOG	DATUM
Anh.			
Tp.			
H.			
Tr.			
Dg.			
B.L.			
L.			
K.C.			
B.K.C.			
Ce.			
C.			
M.			
M.			
K.			
Mz.			
Mq.			
V.			
S.			
S.			
A.			
R.			
Pf.			
G.			
T.D.			

Loc. in Sec. \_\_\_\_\_

SE SE NW

Geol. \_\_\_\_\_

Contr. \_\_\_\_\_

Co. tools

Pool \_\_\_\_\_

NW Walz

**FIRST REPORT**

0

**SEP 3 '58**

Date Comm. \_\_\_\_\_

Location

Co.  
Lse.  
No.  
Sec.  
T.  
R.

~~Top~~ ~~Foot~~

~~Co.~~ ~~Face~~

S-513-B

Co.

County Trego Elev. 20670E-2070RB

Sec. 12 Twp. 11 Rge. 21W

Company Imperial

Farm Name Walz No. 1

TOPS	DEPTH	LOG	DATUM	Loc. in Sec.
Anh.	<u>1505</u>			<u>SE SE 1/4</u>
Tp.				
H.	<u>3330</u>			
Tr.	<u>3352</u>			
Dg.				
B.L.				
L.	<u>3368</u>			
K.C.				Geol.
B.K.C.				Contr.
Ce.				<u>Co. tools</u>
C.	<u>3646</u>			Pool
M.				<u>NW Walz</u>
M.				
K.				
Mz.				
Mq.				
V.				
S.				
S.				
A.				
R.				
Pf.				
G.				
T.D.	<u>3823</u>			

**ABANDONED**

SEP 17 '58

Atlantic Fb  
Mag AC

Date Comm. 9-2-58

Location SEP 10 '58 218/175 Ø3280

SEP 17 '58 DST 3538 -58 60' 10'M SPRUI

BHP 30

D&A

No.

Sec.

No.

Sec.

T.

R.