
Trego KANSAS

SECTION 12 TOWNSHIP 11 RANGE 21W

WELL NO. #1 Williams

COMPANY Imperial

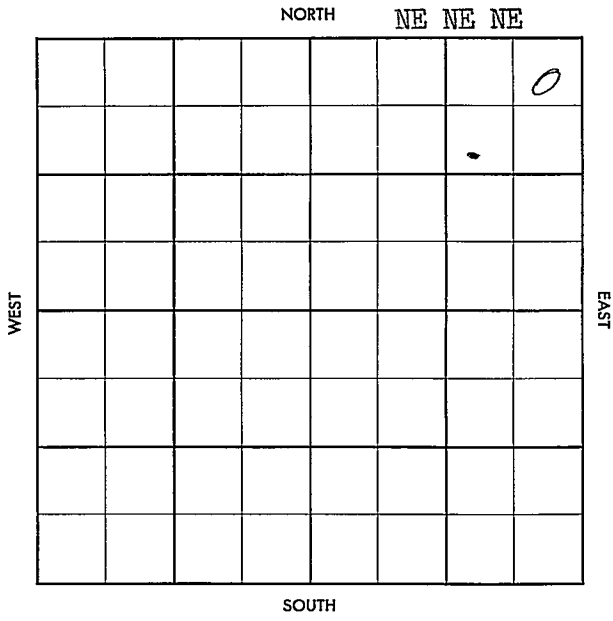

1

FORM 504-3 SUNRAY

FORM 513 SUNRAY

County Trego Elev.

Sec. 12 Twp. 11 Rge. 21W

Company Imperial

Farm Name Williams No. 1

TOPS	DEPTH	LOG	DATUM
Anh.			
Tp.			
H.			
Tr.			
Dg.			
Bl.			
L.			
K.C.			
B.K.C.			
Ce.			
C.			
M.			
M.			
K.			
Mz.			
Mq.			
V.			
S.			
S.			
A			
R.			
P€.			
G.			
T.D.			

Loc. in Sec. NE NE NE

Geol.

Contr. Co. Tools

Pool

FIRST REPORT
APR 24 '57

Date Comm. 4-20-57

8" @ 191/175, Drlg. 2475

Co. Lse. No. Sec. T. R.

FORM 513 SUNRAY

County Trego Elev. 2073 Co.

Sec. 12 Twp. 11 Rge. 21W

Company Imperial

Farm Name Williams No. 1

TOPS	DEPTH	LOG	DATUM
Anh.			
Tp.			
H.	3334		
Tr.	3355		
Dg.			
Bl.			
L.	3371		
K.C.			
B.K.C.			
Ce.			
C.	3651		
M.			
M.			
K.			
Mz.			
Mo.			
V.			
S.			
S.			
A rework	3707		
R.			
P€.			
G.			
T.D.	3740		

Loc. in Sec. NE NE NE

Geol.

Contr. Co. Tools

Lse.

Pool

ABANDONED

MAY 8 '57

No.

Date Comm. 4-20-57 Mag F. O.

Sec.

8" @ 191/175, Drlr. 2475 MAY 7 '57 DST 3399-3422 1hr 3' Md BHP 150/20" DST 3442-54 1hr 5' Md BHP 900/20" DST 3500-24 1hr 4' Md BHP 1140/ DST 3555-78 1hr 5' OCM BHP 70 DST 3650-60 1hr 8' Md BHP 140 @ 3660 MAY 8 '57 DST 3649-70 1hr

T.

R.

FORM 513-1 SUNRAY

rec 12' Md DHP 605 DST
3718-40 1hr 180' SW BHP 900

DEQ

12-11-21 W