


Section 12 Township 11 Range 31W

Well No. #1 Swart

Company Musgrove Petroleum et al

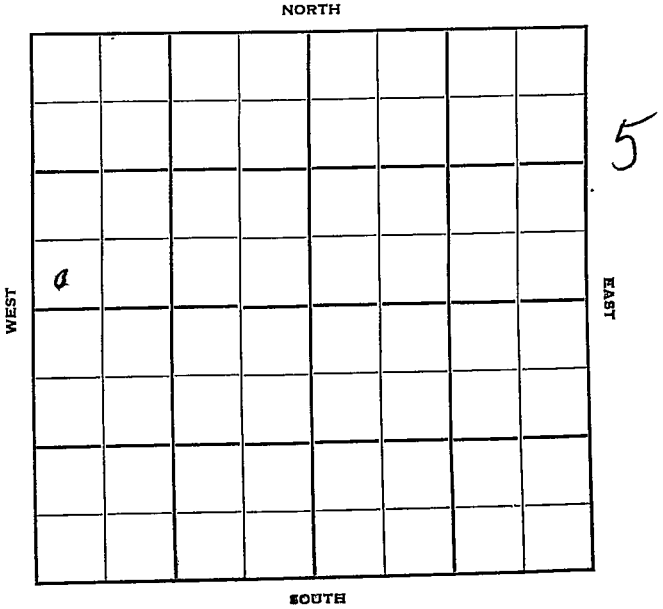

Sec. 12 Twp. 11 R. 31W

Well No. #1 Swart Farm

Musgrove Petroleum et al Company


Wildcat Contractor

 Ft. from N. Line

330 Ft. from S. Line

 Ft. from E. Line

330 Ft. from W. Line

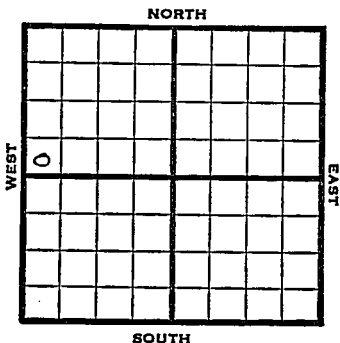

SW SW NW

Lario & CSO - DHM

1951 Elev. 2938' REPORT

10/26 Location

11/28 Spud 11-4-51

D&A TD 4706

8" @ 180

Heeb. 3951 Lans. 3992

DST 4046-89 Rec. 1000' sul wtr.

DST 4089-4132 open 1 hr.

Rec. 540' gas & wtr. 420' SW

DST 4165-99 open 1 hr.

Rec. 360' gas 90' OCM

Marm. 4259 Lime 4288

DST 4389-4417 open 1 hr.

Rec. 1710' muddy wtr.

DST 4521-53 open 1 hr.

Rec. 12' mud

Miss 4562

DST 4564-4607 open 1 hr.

Rec. 210' muddy SW

TD 4706

D&A

ABANDONED

County Gove State Kansas

Sec. 12 (Blk. Twp.) 11 (Sur. Rge.) 31W Map No.

Operator Musgrove Petroleum et al.

Well No. 1 Farm Swart

Elev. 2938 Location SW SW NW

330 Ft. From S Line NW

330 Ft. From W Line Quarter

1st. Report

Completion NOV 28 1951

Remarks Wildcat

Spudding Date 11-4-51

Drig. Data D & A TD 4706

8" @ 180 Heeb. 3951 Lans. 3992

DST 4046-89 Rec. 1000' sul. water

DST 4089-4132 open 1 hr. Rec. 540' gas

& water 420' sw DST 4165-99 open 1 hr.

Rec. 360' gas 90' ocm Marm. 4259

Lime 4288 DST 4389-4417 open 1 hr.

Rec. 1710' muddy water DST 4521-53

open 1 hr. Rec. 12' mud Miss. 4562

DST 4564-4607 open 1 hr. Rec. 210' muddy

sw TD 4706

D & A

J. E. TYRA