

Sec. 12 Twp. 11 R. 17W

Well No. #1 Kress Farm

Ash-Mar Drlg. Company

K & E Drlg. Contractor

Bemis-Shutts Pool

 Ft. from N. Line

990


 Ft. from S. Line

 Ft. from E. Line

330

 Ft. from W. Line

NW SW SE

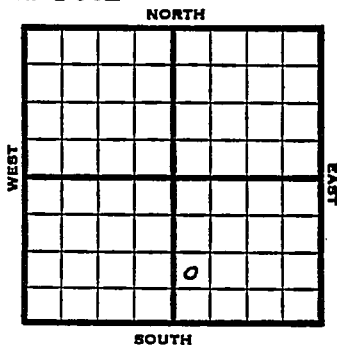

1953

Elev. 1808r

REPORT

6/24

Spud 6-19-53

8" @ 206'

Drlg 2050'

7/1

Top 2713

DST 2913-60, 2 hrs., 10' M, 580#

Heeb 2944, Lans 2985

DST 3034-57, 2 hrs., 80' HOCM, 500#

DST 3069-85, 2 hrs., 90' gas, 90'

SOCM, 90' V, 60' SW, 580#

DST 3138-72, 2 hrs., 10' HOCM, 90' SW
Drlg.

7/8

Spud 6-19-53

D & A

TD 3390'

8" @ 206'

Top 2713,

DST 2913-60 opn 2 hr, rec 10' mud, 580#

Heeb 2944, Lans 2985,

DST 3034-57 opn 2 hr, rec 80' hocm
500#

DST 3069-85 opn 2 hr, rec 90' gas, 90'
socm 90' wtr. 60' sw 580#

DST 3138-72 opn 2 hr, rec 10' hocm
90' sw Cong 3266, Arb 3340

DST 3342-57 opn 2 hr, rec 1950' sw &
SSO 840#

TD 3390'

D & A

ABANDONED

