


Section 12 Township 11 Range 17-W

Well No. #2 Cress

Company Gulf

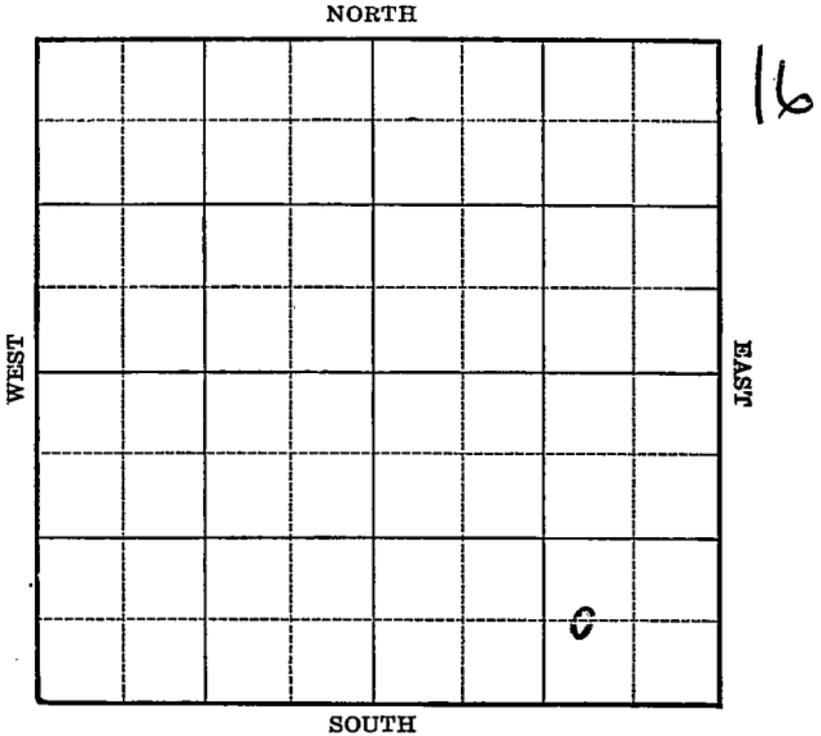

Sec. 12 Twp. 11 R. 17-W

Well No. #2 Cress Farm \_\_\_\_\_

Gulf Company \_\_\_\_\_

(Bemis)


\_\_\_\_\_ Ft. from N. Line

610 Ft. from S. Line

920 Ft. from E. Line

\_\_\_\_\_ Ft. from W. Line

Elev. 1773

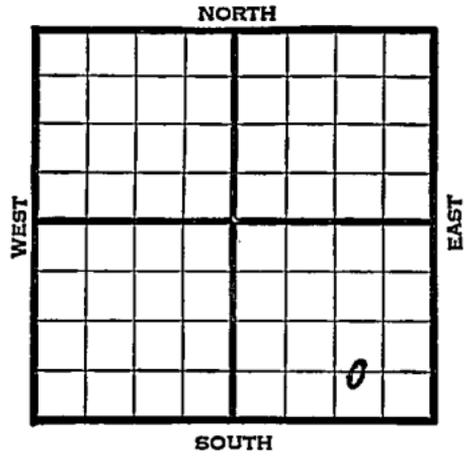

1941	REPORT
2/5	Location
2/13	13" - 75'
	TD 400' SD.
2/20	Drlg. 2275'
2/26	Drlg. 3260'
3/6	Arb. 3300-03 $\frac{1}{2}$ ' T.D. 5" - 3300 $\frac{1}{2}$ '
	Swab 223 bbls. in 5 hours.
3/13	" " " "
3/19	Arb. 3300'
	5" - 3300 $\frac{1}{2}$ '
	T.D. 3303 $\frac{1}{2}$ '
	1000 acid.
	Sonimeter potential 10,083 bbls
	Maximum 3000 bbls.
	33.5 Gravity
	<b>COMPLETED</b>

Map No. 71 Sec. 12 Twp. 11 R. 17WWell No. 2 Cress

Gulf

Company

**FIRST REPORT**

Contractor

C W L SE SE

         Ft. from N. Line610 Ft. from S. Line990 Ft. from E. Line         Ft. from W. Line

BEMIS POOL

**SECTION PLAT**


Location XRig up         

Drilling and Remarks:

**RECORD**Cased          in.,          ft.Sand         Gas         Oil         Total Depth         **PRODUCTION**1st 24 hrs. Nat.         1st 24 hrs. after shot         Gas          Cu. Ft.Dry Hole         Abandoned         

Date

FEB 5 1941<sub>19</sub>S. J. LEWIS

Scout

Map No. 71 Sec. 12 Twp. 11 R. 17W

Well No. 2 Cress

Gulf Company

Contractor

**COMPLETED**

C W L S E S E

**SECTION PLAT**

			0

         Ft. from N. Line

610 Ft. from S. Line

990 Ft. from E. Line

         Ft. from W. Line

BEMIS POOL

Location                                 

Rig up                                 

Drilling and Remarks:

*Per 3300*

*5" @ 3300 1/2*

*1000 acid*

*Committed Per 10073*

*Mag 3000*

*33 5 Gr*

**RECORD**

Cased          in.,          ft.

Sand                                 

Gas                                 

Oil                                 

Total Depth 3303 1/2

**PRODUCTION**

1st 24 hrs. Nat.                                 

1st 24 hrs. after shot                                 

Gas                                  Cu. Ft.

Dry Hole                                 

Abandoned                                 

Date

MAR 19 1941 19

S. J. LEWIS Scout