


Section 12 Township 11 Range 17-W

Well Number 1 Cress

Company Gulf

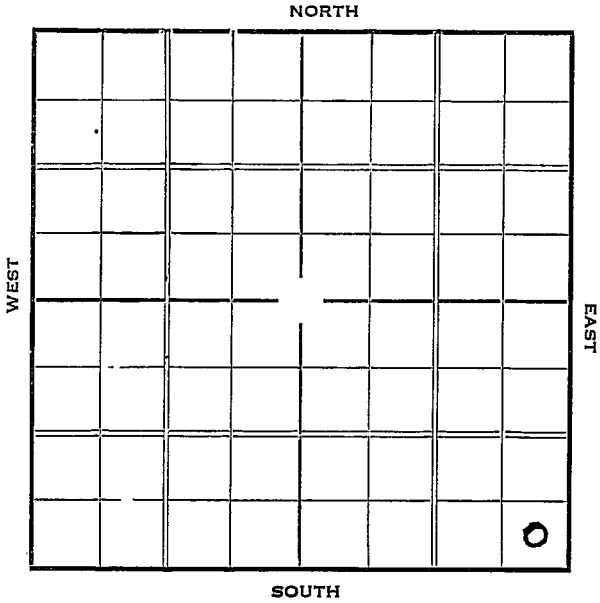

KANSAS

Ellis

Sec. 12 Twp. 11 R. 17-W

Well No. #1 Cross Farm _____
Gulf Company


_____ Ft. from N. Line

330 Ft. from S. Line

480
~~500~~ Ft. from E. Line

_____ Ft. from W. Line

Elev. 1771

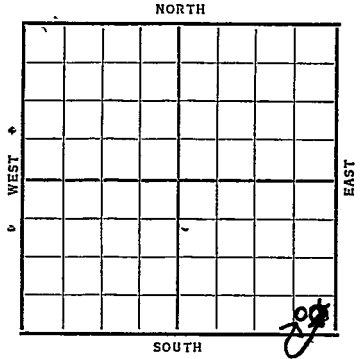

| Date | REPORT |
|------|------------------------------|
| 1937 | |
| 3/24 | R O G |
| 4/2 | " |
| 4/8 | Rigging up. |
| 4/16 | 15" @ 290' WOC |
| 4/23 | Drlg. 980'. |
| 4/30 | Drlg. 2150'. |
| 5/7 | Drlg. 3058'. |
| 5/14 | Sil. 3285'. 6" @ 3285'. |
| | Cored 3280-90'. Last 5' Sat. |
| | T.D. 3295'. RUST. |
| 5/21 | T.D. 3295'. 2600' oil 30 |
| | minutest. |
| | |
| | |
| | |
| | |
| | |
| | |
| | |

OVER

1937

5/26

6" @ 3285'.

Sil. 3285'.

T.D. 3295'.

Pumped 1084 bbls. 12 hrs.

Potential 2168 bbls.

COMPLETED

KANSAS *Ellis*

Map No. 71 Sec. 12 Twp. 11 R. 17W.

Well No. 1 Cross

Gulley Company
Contractor

SECTION PLAT

| | | | |
|--|--|--|---|
| | | | |
| | | | |
| | | | |
| | | | o |

_____ Ft. from N. Line

330 Ft. from S. Line

330 Ft. from E. Line

_____ Ft. from W. Line

FIRST REPORT

Location _____

Rig up _____

Drilling and Remarks:

ROG

RECORD

Cased _____ in., _____ ft.

Sand _____

Gas _____

Oil _____

Total Depth _____

PRODUCTION

1st 24 hrs. Nat. _____

1st 24 hrs. after shot _____

Gas _____ Cu. Ft.

Dry Hole _____

Abandoned _____

Date
MAR 24 1937

[Handwritten scribbles and lines]

[Handwritten signature]

| | |
|-----------------------|---------------------------|
| Returned | |
| Cards | <i>Paul</i> |
| Tracing | <i>Joe</i> |
| France Map | |
| Scarborough Map | <i>[Handwritten mark]</i> |
| Moody Map | |
| Scarborough Flat Book | |
| Moody Flat Book | |

KANSAS *Ellis*

Map No. 71 Sec. 12 Twp. 11 R. 17W

Well No. 1 Cross

Gulf. Company

Contractor

SECTION PLAT

| | | | |
|--|--|--|--|
| | | | |
| | | | |
| | | | |
| | | | |

_____ Ft. from N. Line

330 Ft. from S. Line

480 Ft. from E. Line

_____ Ft. from W. Line

CORRECTION

Location _____

Rig up _____

Drilling and Remarks:

*Reported
330 from S. L. and
330 " E L
should be.
480 from E L and
330 " S. L.*

RECORD

Cased _____ in., _____ ft.

Sand _____

Gas _____

Oil _____

Total Depth _____

PRODUCTION

1st 24 hrs. Nat. _____

1st 24 hrs. after shot _____

Gas _____ Cu. Ft.

Dry Hole _____

Abandoned _____

Date

MAR 31 1937 19

S. J. LEWIS

Scout

[Handwritten scribbles and lines]

| |
|-----------------------------|
| Returned |
| Cards |
| Tracing |
| France Map |
| Scarborough Map |
| Moody Map |
| Scarborough Plat Book |
| Moody Plat Book |

Ellis **KANSAS**

Map No. _____ Sec. 12 Twp. 11 R. 17 ^W

Well No. 1 - Cross

Gulf Company

Contractor _____

COMPLETED

SECTION PLAT

_____ Ft. from N. Line

330 Ft. from S. Line

480 Ft. from E. Line

_____ Ft. from W. Line

| | | | |
|--|--|--|---|
| | | | |
| | | | |
| | | | |
| | | | 0 |

Location _____

Rig up _____

Drilling and Remarks:

Pumped 1084 / 12 hrs

pot. - 2168

RECORD

Cased 6 in., 3285 ft.

Sand 511 - 3285

Gas _____

Oil _____

Total Depth 3295

PRODUCTION

1st 24 hrs. Nat. _____

1st 24 hrs. after shot _____

Gas _____ Cu. Ft.

Dry Hole _____

Abandoned _____

Date

MAY 26 1937 19

H. D. Hatfield

Scout

15

[Handwritten signature]

| | |
|-----------------------|--------------------|
| Returned | <i>[Signature]</i> |
| Cards | <i>[Signature]</i> |
| Tracing | <i>[Signature]</i> |
| France Map | <i>[Signature]</i> |
| Scarborough Map | <i>[Signature]</i> |
| Moody Map | <i>[Signature]</i> |
| Scarborough Plat Book | |
| Moody Plat Book | |