

KANSAS

Ellis


Form 51-5M-7-39-Palace

O.W.W.O.

Section 12 Township 11 Range 18-W

Well No. #3 Kempe

Company Skelly

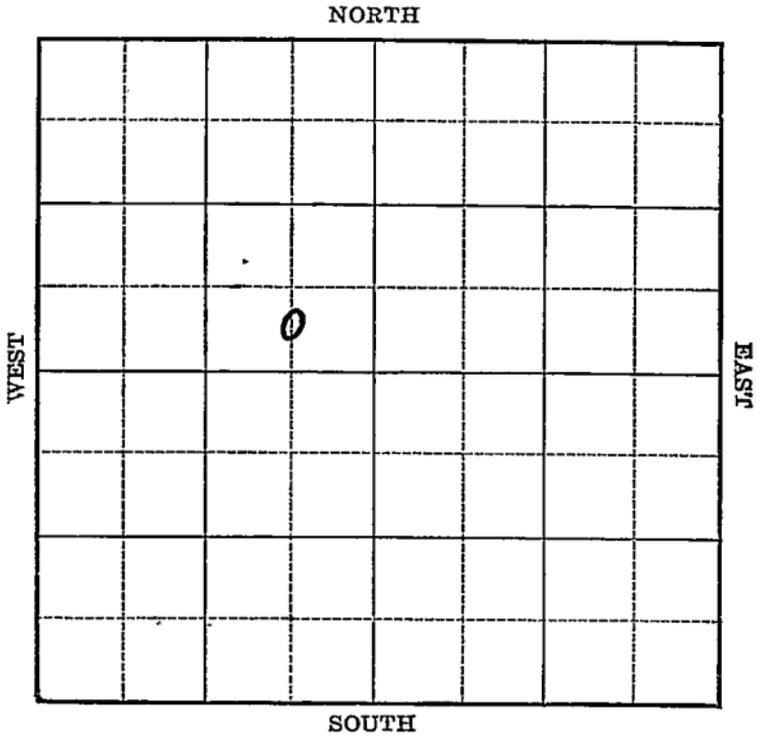

Sec. 12 Twp. 11 R. 18-W

Well No. #3 Kempe Farm

Skelly Company

(South Burnett)


_____ Ft. from N. Line

330 Ft. from S. Line

66.0 Ft. from E. Line

_____ Ft. from W. Line

Elev. 1854

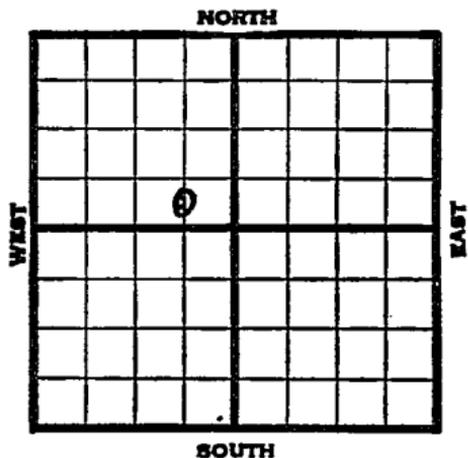

1940	REPORT
1/24	Location
2/1	Rotary.
2/8	16" - 45' Anhy 1108'
	T.D. 1111' Run 8" .
2/15	Dr1g. 2368'
2/23	Lans. 3086' Arb. 3355-58' T.D.
	5" - 3356' RUST.
2/29	" " "
3/6	Arb. 3355'
	5" - 3356'
	T.D. 3359'
	500 acid.
	Echometer potential 40,040 bbls.
	Maximum 3000 bbls.
	COMPLETED
	OVER

1952
2/27

O.W.W.O.

- Topeka 2820' Heeb 3025' Tor. 3043'
Lans. 3067' Arb. 3351-97'
OTD 5" @ 3356' RUST PB 3238'
Perf 72/3228-36 B/28 gal. WPH for
5 hrs. PB 3224' 9/3102-05
Fill up 1000' wtr SSO 12 hrs.
PB 3097 45/3085-90 B/1½ BWPB SSO
for 2 hrs. PB 3080' 90/3045-55
B/3 BWPB for 8 hrs. PB 3040'
15/2983-88' Fill 850' wtr.
PB 2979' 54/2967-73 B/25 gal
oil plus 5 BWPB for 12 hrs. 500 A
P/46 B0 plus 34 BW in 10 hrs.
P/83 B0 plus 12 BW 24 hrs.
Comp.

FIRST REPORT
of
COMPLETED

Map No. 71 Sec. 12 Twp. 11 R. 18W

Well No. 3 Kempe
Skelly Company

Contractor

SECTION PLAT

C S L SE NW

_____ Ft. from N. Line

330 Ft. from S. Line

660 Ft. from E. Line

_____ Ft. from W. Line

SOUTH BURNETT POOL

Location X

Rig up _____

Drilling and Remarks:

RECORD

Cased _____ in., _____ ft.

Sand _____

Gas _____

Oil _____

Total Depth _____

PRODUCTION

1st 24 hrs. Nat. _____

1st 24 hrs. after shot _____

Gas _____ Cu. Ft.

Dry Hole _____

Abandoned _____

Date

JAN 2 1940 19

S. J. F.

Scout

Misc. Small Maps *Handwritten initials*
Cards *Handwritten initials*
Tracing *Handwritten initials*
France Map *Handwritten initials*
Scarborough Map *Handwritten initials*
Moody Map
Geological Dept.
Moody Flat Book

Ellis KANSAS

Map No. 71 Sec. 12 Twp. 11 R. 18WWell No. 3 KempeSkelly Company

Contractor

COMPLETED

C S L SE NW

 Ft. from N. Line330 Ft. from S. Line660 Ft. from E. Line Ft. from W. Line

SECTION PLAT

SOUTH BURNETT POOL

Location Rig up

Drilling and Remarks:

500 acid5" c 3256Echometer potential40,040 bblsMaximum3000 bbls

RECORD


Cased in., ft.Sand 3355Gas Oil Total Depth 3359

PRODUCTION

1st 24 hrs. Nat. 1st 24 hrs. after shot Gas Cu. Ft.Dry Hole Abandoned


Date

MAR 6 1940 19S. J. LEWIS Scout

 

11 12 13 

- Misc. Small Maps *DMJ*
- Cards *DMJ*
- Tracing *DMJ*
- France Map *DMJ*
- Scarborough Map *DMJ*
- Moody Map *DMJ*
- Geological Dept.
- Moody Flat Book

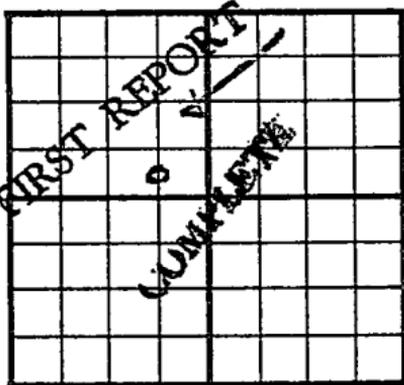County **Ellis** State **Kansas**Sec. **12** (Blk. Twp.) **11** (Sur. Rge.) **18W** Map No.Operator **Skelly Oil**Well No. **3** Farm **Hempe**Elev. **1854** Location **C S/2 SE NW****330** Ft. From **S** Line **NW****660** Ft. From **T** Line **Quarter**1st. Report **FEB 27 1952**Completion **FEB 27 1952**Remarks **OWWO****O.W.W.O.**

Spudding Date

Drlg. Data

Topeka 2820 Heeb 3025 Tor 3043 Lans**3067 Arb 3351-97 OTD 5" @ 3358****Rust PB 3238 Perf 72/3228-36 B/28 gal.****wph for 5 hrs. PB 3224 9/3102-05****fill up 1000' wtr. SSO 12 hrs. PB 3097****45/3085-90 B/1 $\frac{1}{2}$ Bwph SSO for 2 hrs.****PB 3080 90/3045-55 B/3 Bwph for 8 hrs.****PB 3040 15/2983-38 fill 850' wtr. PB 2979****54/2967-73 B/25 gal oil plus 5 Bwph for****12 hrs. 500 A P/46 Bo plus 34 BW in 10 hrs.****P 83 BO plus 12 BW 24 hrs. Comp.****J. G. McGEHEE**

FEB 29 1952

Scout Cards	<i>mm</i>
Land Small Map	
Land Wall Map	
Tracing	
Finance Map	
Pierce Map	
Misc.	

Drig. Data