

KANSAS

Form 51—5M—7-39—Palace

Ellis

Section 13 Township 11 Range 18-W

Well No. #3 Peavey "A"


Company Darby Petroleum

NORTH

Burnett Pool

WEST

EAST

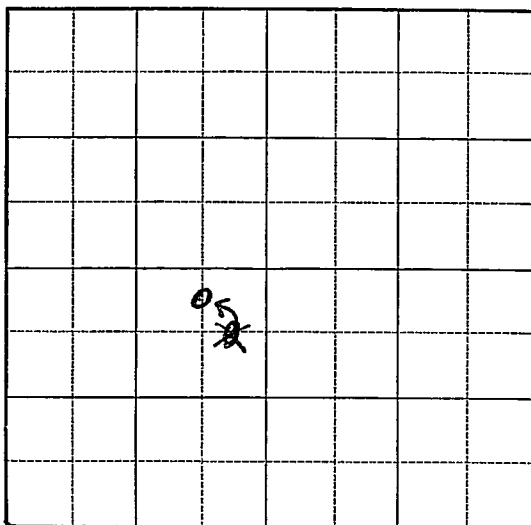

SOUTH

KANSAS

Ellis

Sec. 13 Twp. 11 R. 18-WWell No. #3 Peavey "A" Farm

Darby Petr.

Company

(Burnett)

~~660~~ **330**


Ft. from N. Line

Ft. from S. Line

~~660~~~~330~~

Ft. from E. Line

Ft. from W. Line

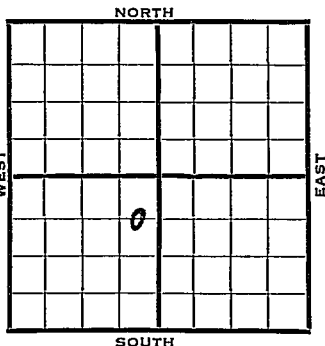

Elev. 1883

1940

REPORT

5/29

Location

6/5

Rigging up rotary.

6/13

15" - 115' Anhy 1076'

10" - 1081' WOC.

6/20

Drlg. 2910'

6/27

Arb. 3344' T.D. 3346½'

7" - 3344½' RUST.

7/3

Recement 7".

7/10

Arb. 3340'

7" - 3340'

T.D. 3348'

500 acid.

Depthograph potential 13,066 bbls.

Maximum 3000 bbls.

COMPLETED

Map No. 71 Sec. 13 Twp. 11 R. 18WWell No. 3 Peavey "A"Darby Petroleum CompanyContractor**FIRST REPORT**
C W L N E SW660 Ft. from N. Line Ft. from S. Line330 Ft. from E. Line Ft. from W. Line**BURNETT POOL****SECTION PLAT**

Location Rig up

Drilling and Remarks:

Location **RECORD**Cased in., ft.Sand Gas Oil Total Depth **PRODUCTION**1st 24 hrs. Nat. 1st 24 hrs. after shot Gas Cu. Ft.Dry Hole Abandoned

Date

MAY 29 1940 19 S. J. LEWIS Scout

Misc. Small Maps	Barry
Cards	Barry
Tracing	Barry
France Map	Barry
Scarborough Map	Barry
Moody Map	
Geological Dept.	
Moody Flat Book	

Map No. _____ Sec. 13 Twp. 11 R. 18WWell No. 3 Peavey "A"

Darby Petroleum Company

Contractor

COMPLETED

SECTION PLAT

C N L NE SW

330 Ft. from N. Line

Ft. from S. Line

660 Ft. from E. Line

Ft. from W. Line

BURNETT POOL

	o		

Location _____

Rig up _____

Drilling and Remarks:

*Ce & 3340**7" C 3340**500 ac oil**Depthograph & 13066**May 3000*

RECORD

Cased _____ in., _____ ft.

Sand _____

Gas _____

Oil _____

Total Depth *3348*

PRODUCTION

1st 24 hrs. Nat. _____

1st 24 hrs. after shot _____

Gas _____ Cu. Ft.

Dry Hole _____

Abandoned _____

Date

III 10 1940 19

S. J. LEWIS

Scout

First report ticket shows this
well as 660' from north line and
330' from east line in the
C E L NE SW.

Please check and advise.

Paul.

Misc. Small Maps.....	<i>Paul</i>
Cards.....	<i>Paul</i>
Tracing.....	<i>Joe</i>
France Map.....	
Scarborough Map.....	
Moody Map.....	<i>Joe</i>
Geological Dept.....	
Moody Plat Book.....	

Map No. _____ Sec. 13 Twp. 11 R. 18W

Well No. 3 Peavey "A"

Darby Petroleum Company

Correction Contractor

C N L NE SW

330 Ft. from N. Line

Ft. from S. Line

660 Ft. from E. Line

Ft. from W. Line

Burnett Pool

SECTION PLAT

	o		

Location _____

Rig up _____

Drilling and Remarks:

Reported

C.E L NE SW

RECORD

Cased _____ in., _____ ft.

Sand _____

Gas _____

Oil _____

Total Depth _____

PRODUCTION

1st 24 hrs. Nat. _____

1st 24 hrs. after shot _____

Gas _____ Cu. Ft.

Dry Hole _____

Abandoned _____

Date

JUL 12 1940 19

S. J. LEWIS Scout

Misc. Small Maps

Cards

Tracing

France Map

Scarborough Map

Moody Map

Geological Dept.

Moody Flat Book