

# KANSAS


FORM 51 5M 4-41 PETROL

Ellis

Section 13 Township II- Range 18-W

Well No. 7 Peavey "A"

Company Darby Petroleum

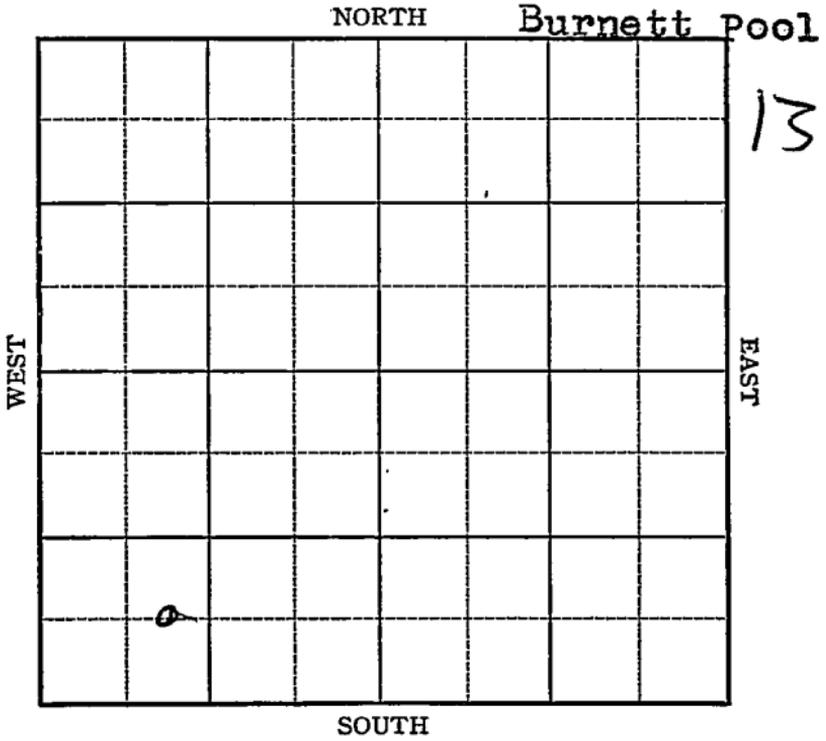



Map No. 71 Sec. 13 Twp. 11 R. 18W

Well No. 7 Peavey "A"

Darby Petroleum Company

FIRST REPORT Contractor

**SECTION PLAT**

C E L SW SW


\_\_\_\_\_ Ft. from N. Line

660 Ft. from S. Line

\_\_\_\_\_ Ft. from E. Line

990 Ft. from W. Line

**BURNETT POOL**

Location X

Rig up \_\_\_\_\_

Drilling and Remarks:

**RECORD**

Cased \_\_\_\_\_ in., \_\_\_\_\_ ft.

Sand \_\_\_\_\_

Gas \_\_\_\_\_

Oil \_\_\_\_\_

Total Depth \_\_\_\_\_

**PRODUCTION**

1st 24 hrs. Nat. \_\_\_\_\_

1st 24 hrs. after shot \_\_\_\_\_

Gas \_\_\_\_\_ Cu. Ft.

Dry Hole \_\_\_\_\_

Abandoned \_\_\_\_\_

Date

MAY 7 1941 19

S. J. LEWIS Scout

Map No. 71 Sec. 13 Twp. 11 R. 18WWell No. 7 Peavey "A"Darby Petroleum Company

Contractor

**COMPLETED**

C E L SW SW

         Ft. from N. Line660 Ft. from S. Line         Ft. from E. Line990 Ft. from W. Line**SECTION PLAT**


BURNETT POOL

Location \_\_\_\_\_

Rig up \_\_\_\_\_

Drilling and Remarks:

*Core 3415*  
*7" @ 3416*  
*5000 cu ft*  
*Sept 1927 35000*  
*May 3000*

*322 gr*

**RECORD**

Cased \_\_\_\_\_ in., \_\_\_\_\_ ft.

Sand \_\_\_\_\_

Gas \_\_\_\_\_

Oil \_\_\_\_\_

Total Depth 3424**PRODUCTION**

1st 24 hrs. Nat. \_\_\_\_\_

1st 24 hrs. after shot \_\_\_\_\_

Gas \_\_\_\_\_ Cu. Ft.

Dry Hole \_\_\_\_\_

Abandoned \_\_\_\_\_

Date

JUN 18 1941S. J. LEWIS

Scout