

KANSAS


FORM 51 5M 4-41 PETROL

Ellis

Section 13 Township 11 Range 18W

Well No. 8 Peavey "A"

Company Darby Petroleum

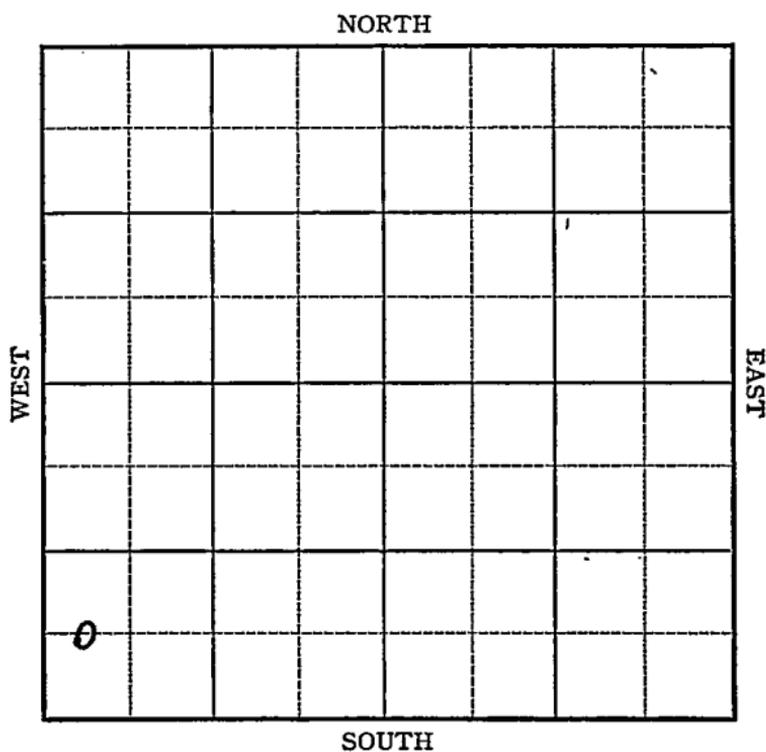

Sec. 13 Twp. 11 R. 18-W

Well No. #8 Peavey "A" Farm

Darby Petr. Company

(Burnett)


_____ Ft. from N. Line

660 Ft. from S. Line

_____ Ft. from E. Line

330 Ft. from W. Line

Elev. 1933

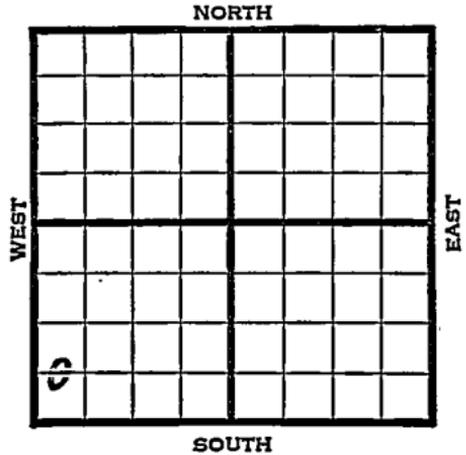

1941	REPORT
6/4	Location
6/12	"
6/19	Rot ary.
6/26	Anhy 1183' 10" - 1188' WOC.
7/3	Drlg. 3300'
7/10	Arb. 3419' 7" - 3420'
	T.D. 3427' 2700' oil 3½ hours.
7/16	Arb. 3419'
	7" - 3420'
	T.D. 3427'
	500 acid.
	Depthograph potential 71,354 bbl
	Maximum 3000 bbls.
	32. Gravity
	COMPLETED

Map No. _____ Sec. 13 Twp. 11 R. 18W

Well No. 8 Peavey "A"

Darby Petroleum Company

Contractor

FIRST REPORT

SECTION PLAT

C W L SW SW

_____ Ft. from N. Line

660 Ft. from S. Line

_____ Ft. from E. Line

330 Ft. from W. Line

o			

BURNETT POOL

Location X

Rig up _____

Drilling and Remarks:

RECORD

Cased _____ in., _____ ft.

Sand _____

Gas _____

Oil _____

Total Depth _____

PRODUCTION

1st 24 hrs. Nat. _____

1st 24 hrs. after shot _____

Gas _____ Cu. Ft.

Dry Hole _____

Abandoned _____

Date

JUN 4 1941 19

S. J. LEWIS Scout

Map No. 71 Sec. 13 Twp. 11 R. 18WWell No. 8 Peavey "A"Darby Petroleum Company

Contractor

COMPLETELY

C W L SW SW

 Ft. from N. Line660 Ft. from S. Line Ft. from E. Line330 Ft. from W. Line

BURNETT POOL

SECTION PLAT

0			

Location Rig up

Drilling and Remarks:

See Y 3419
7" @ 3420
500 Drill
Depth 971354
Max 3000
32 e gr

RECORD

Cased in., ft.Sand Gas Oil Total Depth 3427

PRODUCTION

1st 24 hrs. Nat. 1st 24 hrs. after shot Gas Cu. Ft.Dry Hole Abandoned

Date

JUL 16 1941 19S. J. LEWIS Scout