


Ellis

Section 13 Township 11 Range 18-W

Well No. 1 Peavey

Company Phillips

Peavey Pool

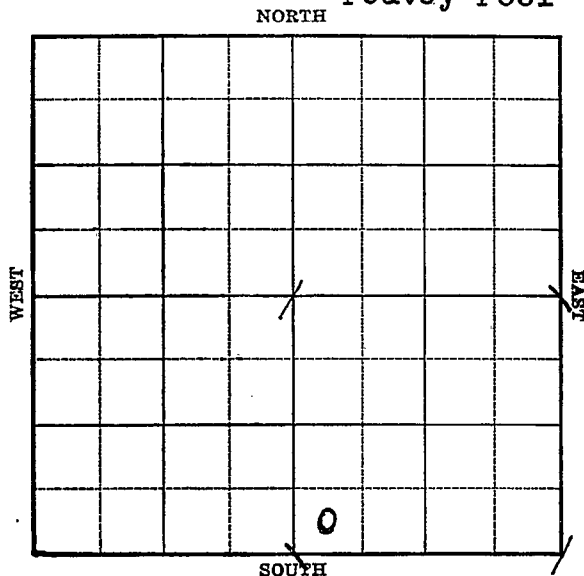


KANSAS**Ellis**Sec. 13 Twp. 11 R. 18-WWell No. #1 Peavey FarmPhillips Company

(Peavy)

 Ft. from N. Line330 Ft. from S. Line Ft. from E. Line330 Ft. from W. Line

Elev. 1918'

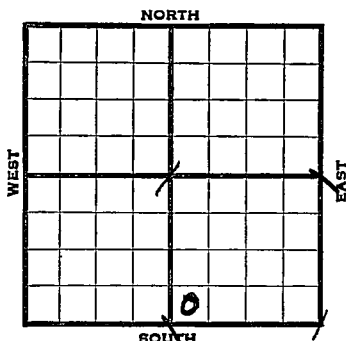

1939	REPORT
3/15	Cellar.
3/24	"
3/31	Anhy 1152' 10" - 1152'
	Drlg. 1425'
4/7	Arb. 3393-95' T.D. S. O.
	5" - 3395'
4/14	" "
4/21	" "
4/28	T.D. 3411' 2750' oil.
	Swab 101 oil in 4 hours.
5/5	" " " " "
5/12	2000 acid. Pump I64 oil 2 bbls.
	WAKK WAKK B. S. 10 hours.
5/17	Arb. 3393'
	5" - 3395'
	T.D. 3411'
	2000 acid.
	Echometer potential 1364 oil,
	No water.
	COMPLETED

Map No. 77 Sec. 13 Twp. 11 R. 18WWell No. 1 PeaveyPhillips


Company

Contractor

FIRST REPORT

SECTION PLAT

SW SE

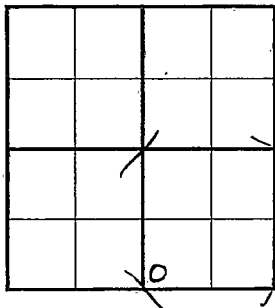 Ft. from N. Line330 Ft. from S. Line Ft. from E. Line330 Ft. from W. Line

PEAVEY POOL

Location Rig up

Drilling and Remarks:

Cellar

RECORD

Cased in., ft.Sand Gas Oil Total Depth

PRODUCTION

1st 24 hrs. Nat. 1st 24 hrs. after shot Gas Cu. Ft.Dry Hole Abandoned

Date

MAR 15 1939

19

L. D. Hatfield Scout

Map No. 71 Sec. 13 Twp. 11 R. 18WWell No. 1 PeaveyPhillips

Company

Contractor

SECTION PLAT

SW SE

 Ft. from N. Line330 Ft. from S. Line Ft. from E. Line330 Ft. from W. Line

PEAVEY POOL

Location Rig up

Drilling and Remarks:

*Art 3393**5" C3395**2000 acid**Echometer Pot.**1364 oil No Water*

RECORD

Cased in., ft.Sand Gas Oil Total Depth 3411

PRODUCTION

1st 24 hrs. Nat. 1st 24 hrs. after shot Gas Cu. Ft.Dry Hole Abandoned

Date

MAY 17 1939 19

S. J. LEWIS Scout