

KANSAS


Form 51—5M—11-38—Palace

Ellis

Section 13 Township 11 Range 18-W

Well No. #2 Peavey

Company Phillips

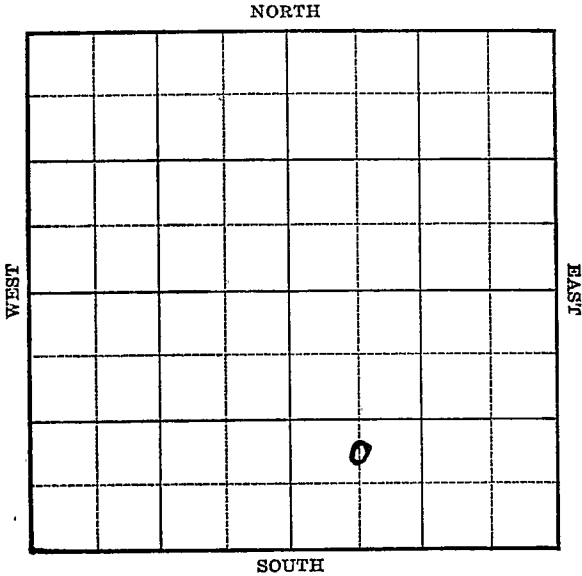


KANSAS

Ellis

Sec. 13 Twp. 11 R. 18-WWell No. #2 Peavey FarmPhillips Company

(Peavey)

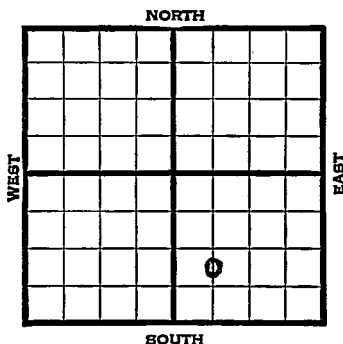 Ft. from N. Line990 Ft. from S. Line Ft. from E. Line660 Ft. from W. Line

Elev. 1948

1939	REPORT
7/19	13" - 72' Anhy. 1159'
	1171' run 8".
7/26	8" - 1169' Drilg. 2872'
8/3	Lans. 3120' S.O. 3200'
	Arb. 3415 ³⁴¹⁵ T.D. 3415' Run 5".
8/10	Arb. 3415' & 5" (Corrected)
	RUST.
8/17	T.D. 3418½' 2950' oil.
8/24	Shut down.
8/31	" "
9/6	Arb. 3415'
	5" - 3415'
	T.D. 3418½'
	Depthograph Pot. 4500 bbls.
	Maximum 2500 bbls.
	COMPLETED

Map No. 71 Sec. 13 Twp. 11 R. 18WWell No. 2 PeaveyPhillips

Company

Contractor

FIRST REPORT

C $N\frac{1}{2}$ SW SE Ft. from N. Line990 Ft. from S. Line Ft. from E. Line660 Ft. from W. Line

SECTION PLAT

PEAVEY POOL

Location Rig up

Drilling and Remarks:

13" - 72Anhy. 11591171 Run 8"

RECORD

Cased in., ft.Sand Gas Oil Total Depth

PRODUCTION

1st 24 hrs. Nat. 1st 24 hrs. after shot Gas Cu. Ft.Dry Hole Abandoned

Date

JUL 19 193919S. J. LEWISScout

KANSAS

Ellis

Map No. 71 Sec. 13 Twp. 11 R. 18WWell No. 2 PeaveyPhillips

Company

Contractor

COMPLETED

C $N\frac{1}{2}$ SW SE

Ft. from N. Line

990 Ft. from S. Line

Ft. from E. Line

660 Ft. from W. Line

SECTION PLAT

		o	

PEAVEY POOL

Location _____

Rig up _____

Drilling and Remarks:

*At 3415**5" @ 3415.**Depthograph 28.**4500**Maximum 2500*

RECORD

Cased _____ in., _____ ft.

Sand _____

Gas _____

Oil _____

Total Depth 3418 1/2

PRODUCTION

1st 24 hrs. Nat. _____

1st 24 hrs. after shot _____

Gas _____ Cu. Ft.

Dry Hole _____

Abandoned _____

Date

SEP 6 1939₁₉

S. J. LEWIS Scout