


Form 51-5M-7-40-Palace

Section 13 Township 11 Range 18-W

Well No. #7 Hadley "B"

Company Darby Petr.

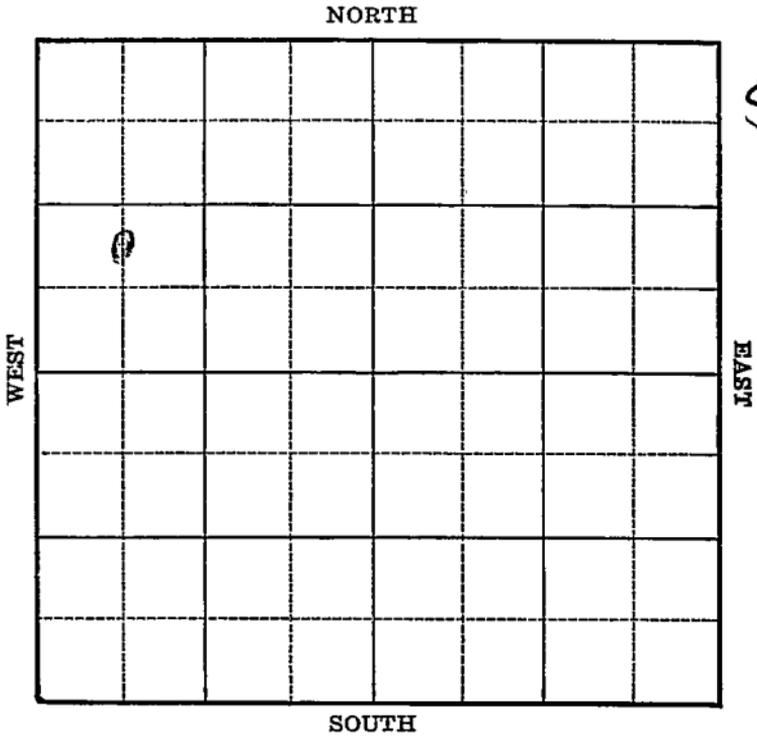

Sec. 13 Twp. 11 R. 18-W

Well No. #7 Hadley "B" Farm

Darby Petr. Company

(Burnett)


_____ Ft. from N. Line

990 Ft. from S. Line

_____ Ft. from E. Line

660 Ft. from W. Line

Elev. 1863

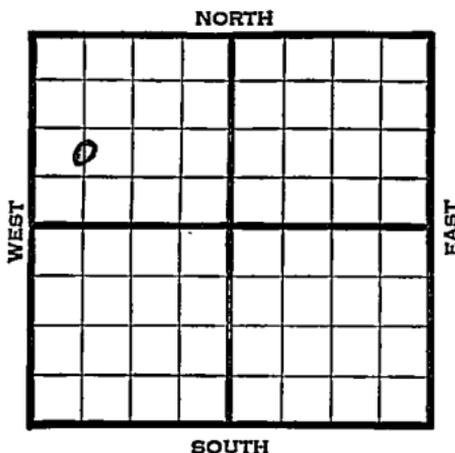

1941	REPORT
2/5	Derrick.
2/13	"
2/20	"
2/26	"
3/6	"
3/13	15" - 91' Anhy 1092'
	10" - 1100' WOC.
3/20	Drlg. 3300'
3/27	Arb. 3338' 7" - 3338'
	T.D. 3345' 2900' oil 5 hours.
	500 acid.
4/2	Arb. 3338'
	7" - 3338'
	T.D. 3345'
	500 acid.
	Depthograph potential 57,263 bbl
	Maximum 3000 bbls.
	32. Gravity
	COMPLETED

Map No. 71 Sec. 13 Twp. 11 R. 18W

Well No. 7 Hadley "B"

Darby Petroleum Company

COMPLETED Contractor

SECTION PLAT

C N L SW NW

o			

_____ Ft. from N. Line

990 Ft. from S. Line

_____ Ft. from E. Line

660 Ft. from W. Line

BURNETT POOL

Location _____

Rig up _____

Drilling and Remarks:

Ar 3338
7" C 3338
500 cu oil
Dep't. P. 57263
Max 3000

32° Gr

RECORD

Cased _____ in., _____ ft.

Sand _____

Gas _____

Oil _____

Total Depth 3345.

PRODUCTION

1st 24 hrs. Nat. _____

1st 24 hrs. after shot _____

Gas _____ Cu. Ft.

Dry Hole _____

Abandoned _____

Date

APR 2 1941 19

S. J. LEWIS Scout