


Ellis KANSAS

Section 13 Township 11 Range 18-WWell No. #6 HendrickCompany Phillips

NORTH Burnett Arb.Pool

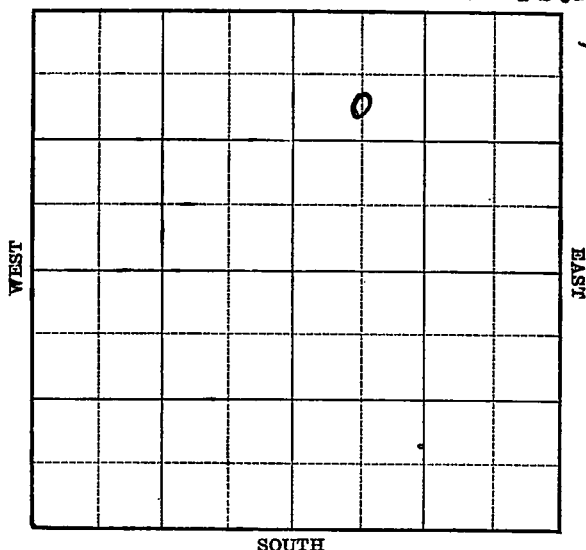

Map No. 71 Sec. 13 Twp. 11 R. 18WWell No. 6 HendrickPhillips

Company

Contractor

FIRST REPORT

C S $\frac{1}{2}$ NW NE990 Ft. from N. Line Ft. from S. Line Ft. from E. Line660 Ft. from W. Line

BURNETT ARB. POOL

SECTION PLAT

		o	

Location XRig up

Drilling and Remarks:

RECORD

Cased in., ft.Sand Gas Oil Total Depth

PRODUCTION

1st 24 hrs. Nat. 1st 24 hrs. after shot Gas Cu. Ft.Dry Hole Abandoned

Date

FEB 14 1940 19

S. J. LEWIS Scout

Ellis

KANSAS

Map No. 71 Sec. 13 Twp. 11 R. 18WWell No. 6 HendrickPhillips Petroleum

Company

Contractor

COMPLETED

SECTION PLAT

C S $\frac{1}{2}$ NW NE990 Ft. from N. Line

Ft. from S. Line

Ft. from E. Line

660 Ft. from W. Line

		0	

BURNETT ARB. POOL

Location _____

Rig up _____

Drilling and Remarks:

*Cu & 3369 1/2.**5" C 3369 1/2.**Echometer Log**13 210**Maximum 3000*

RECORD

Cased _____ in., _____ ft.

Sand _____

Gas _____

Oil _____

Total Depth 3395 1/2

PRODUCTION

1st 24 hrs. Nat. _____

1st 24 hrs. after shot _____

Gas _____ Cu. Ft.

Dry Hole _____

Abandoned _____

Date

MAR 27 1940 19

S. J. LEWIS Scout