

# KANSAS


Form 51—5M—11-38—Palace

Ellis

Section 13 Township 11 Range 18-W

Well No. #1 Hadley "B"

Company Darby

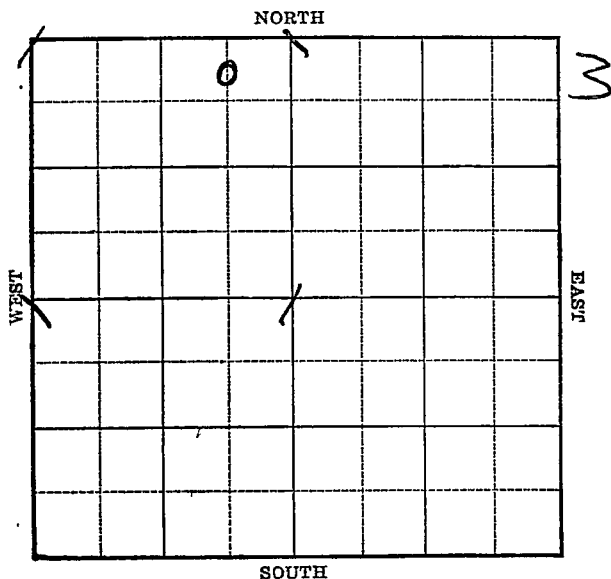

KANSAS

Ellis

Sec. 13 Twp. 11 R. 18-WWell No. #1 Hadley "B" FarmDarby

Company

(Peavey)


330 Ft. from N. Line

Ft. from S. Line

660 Ft. from E. Line

Ft. from W. Line

Elv. 1860

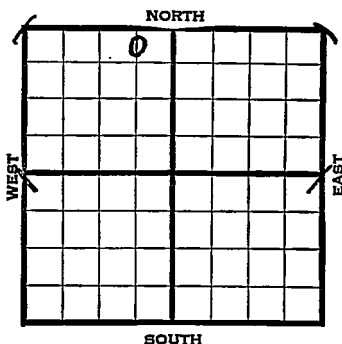

| 1939 | REPORT                       |
|------|------------------------------|
| 7/26 | Location                     |
| 8/3  | Surface hole.                |
| 8/10 | 16" - 94' Anhy 1095'         |
|      | 10" - 1095' Drlg. 1969'      |
| 8/17 | Simp. Dolo. 3330' Arb. 3348' |
|      | 7" - 3348' T.D. 3349' RUST.  |
| 8/24 | T.D. 3358' 1550' oil 4½ hrs. |
|      | Shut down.                   |
| 8/31 | " "                          |
| 9/7  | " "                          |
|      | -                            |
| 9/13 | Arb. 3348'                   |
|      | 7" - 3348'                   |
|      | 2000 acid.                   |
|      | T.D. 3358'                   |
|      | Depthograph potential 92,000 |
|      | bbls. Maximum 2500 bbls.     |
|      | COMPLETED                    |
|      |                              |
|      |                              |
|      |                              |

Ellis

KANSAS

Map No. 71 Sec. 13 Twp. 11 R. 18WWell No. 1 Hadley "B"Darby


Company

Contractor

## FIRST REPORT

C  $N\frac{1}{2}$  NE NW330 Ft. from N. Line       Ft. from S. Line660 Ft. from E. Line       Ft. from W. Line

## SECTION PLAT

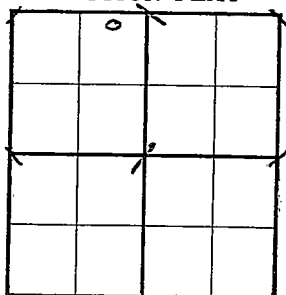

## PEAVEY POOL

Location XRig up       Drilling and Remarks:       

## RECORD

Cased        in.,        ft.Sand       Gas       Oil       Total Depth       

## PRODUCTION

1st 24 hrs. Nat.       1st 24 hrs. after shot       Gas        Cu. Ft.Dry Hole       Abandoned       

Date

JUL 26 1939

19

S. I. LEWIS

Scout

Ellis

KANSAS

Map No. \_\_\_\_\_ Sec. 13 Twp. 11 R. 18WWell No. 1 Hadley "B"

Darby

Company

Contractor

COMPLETED

C  $N\frac{1}{2}$  NE NW330 Ft. from N. Line


\_\_\_\_\_ Ft. from S. Line

660 Ft. from E. Line

\_\_\_\_\_ Ft. from W. Line

PEAVEY POOL

## SECTION PLAT

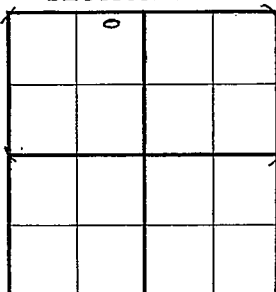

Location \_\_\_\_\_

Rig up \_\_\_\_\_

Drilling and Remarks:

*Cu 83348*  
*7" @ 3348*  
*2000 acid*  
*Depthograph 88*  
*92000*  
*Maximum 2500*

## RECORD

Cased \_\_\_\_\_ in., \_\_\_\_\_ ft.

Sand \_\_\_\_\_

Gas \_\_\_\_\_

Oil \_\_\_\_\_

Total Depth 3258

## PRODUCTION

1st 24 hrs. Nat. \_\_\_\_\_

1st 24 hrs. after shot \_\_\_\_\_

Gas \_\_\_\_\_ Cu. Ft.

Dry Hole \_\_\_\_\_

Abandoned \_\_\_\_\_

Date

SEP 12 1939 19

S. J. LEWIS

Scout