



Sec. 13 Twp. 11 R. 18-W

Well No. #6 Hadley "B" Farm

Darby Company

(Burnett)


990 Ft. from N. Line

\_\_\_\_\_ Ft. from S. Line

\_\_\_\_\_ Ft. from E. Line

660 Ft. from W. Line

Elev. 1862

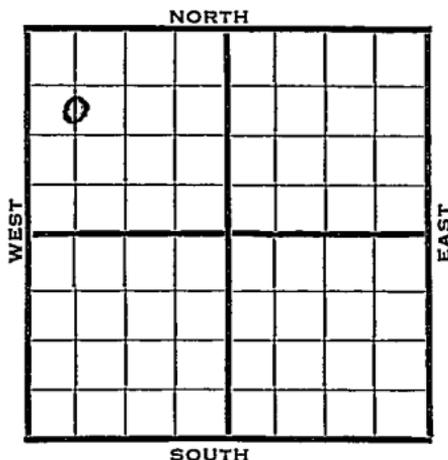

	REPORT
1941	
1/29	Derrick.
2/6	"
2/13	"
2/20	15" -94' Drlg. 500'
2/26	Anhy 1098' 10" - 1111'
	Drlg. 2200'
3/6	Simp. Dolo. 3325'
	Simp. sh. 3331' Simp. sand <del>3333</del>
	3334 1/2' Arb. 3343-44' T.D.
	7" - 3344' RUS <sup>T</sup> .
3/13	" " "
3/19	Arb. 3343'
	7" - 3344'
	T.D. 3353'
	500 acid.
	Dep thograph potential 53,826 bbl
	Maximum 3000 bbls.
	32. Gravity
	<b>COMPLETED</b>

Map No. 71 Sec. 13 Twp. 11 R. 18WWell No. 6 Hadley "B"Darby Company~~FIRST REPORT~~ Contractor

## SECTION PLAT

C S L NW NW

990 Ft. from N. Line         Ft. from S. Line         Ft. from E. Line660 Ft. from W. Line


BURNETT POOL

Location                                 Rig up                                 

Drilling and Remarks:

Derrick

## RECORD

Cased                  in.,                  ft.Sand                                 Gas                                 Oil                                 Total Depth                                 

## i PRODUCTION

1st 24 hrs.-Nat.                                 1st 24 hrs. after shot                                 Gas                                  Cu. Ft.Dry Hole                                 Abandoned                                 

Date

JAN 29 1941 19

S. J. LEWIS Scout

Map No. 71 Sec. 13 Twp. 11 R. 18WWell No. 6 Hadley "B"Darby Petroleum

Company

Contractor

**COMPLETED****SECTION PLAT**

C S L NW NW

990 Ft. from N. Line

\_\_\_\_\_ Ft. from S. Line

\_\_\_\_\_ Ft. from E. Line

660 Ft. from W. Line

BURNETT POOL

o			

Location \_\_\_\_\_

Rig up \_\_\_\_\_

Drilling and Remarks:

*Cor 3243**7" @ 3344**500 acid**Dy. H. P. 53826**May 3000**32 @ Gu***RECORD**

Cased \_\_\_\_\_ in., \_\_\_\_\_ ft.

Sand \_\_\_\_\_

Gas \_\_\_\_\_

Oil \_\_\_\_\_

Total Depth 3353**PRODUCTION**

1st 24 hrs. Nat. \_\_\_\_\_

1st 24 hrs. after shot \_\_\_\_\_

Gas \_\_\_\_\_ Cu. Ft.

Dry Hole \_\_\_\_\_

Abandoned \_\_\_\_\_

Date

MAR 19 1941 19

S. J. LEWIS Scout