

KANSAS

Form 51-5M-7-39-Palace

Ellis


Section 13 Township 11- Range 18-W

Well No. #4 Hadley "B"

Company Darby Petroleum

Burnett Pool

NORTH

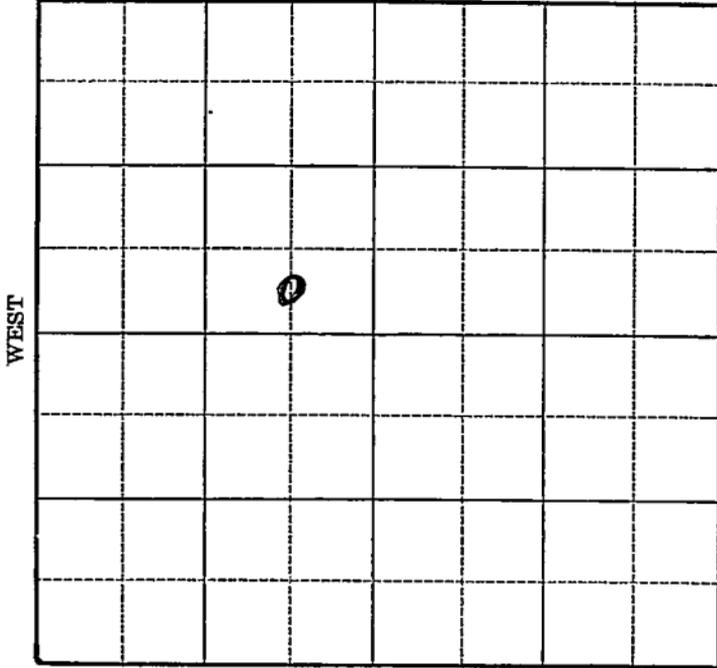

6

WEST

EAST

SOUTH

Map No. 71 Sec. 13 Twp. 11 R. 18W

Well No. 4 Hadley "B"

Darby Petroleum Company

Contractor

FIRST REPORT
C S L SE NW

SECTION PLAT

_____ Ft. from N. Line

330 Ft. from S. Line

660 Ft. from E. Line

_____ Ft. from W. Line

BURNETT POOL

Location X

Rig up _____

Drilling and Remarks:

RECORD

Cased _____ in., _____ ft.

Sand _____

Gas _____

Oil _____

Total Depth _____

PRODUCTION

1st 24 hrs. Nat. _____

1st 24 hrs. after shot _____

Gas _____ Cu. Ft.

Dry Hole _____

Abandoned _____

Date

MAY 29 1940 19

S. J. LEWIS Scout

Map No. 71 Sec. 13 Twp. 11 R. 18W

Well No. 4 Hadley "B"

Darby Petroleum Company

Contractor

COMPLETED

C S L SE NW

_____ Ft. from N. Line

330 Ft. from S. Line

660 Ft. from E. Line

_____ Ft. from W. Line

BURNETT POOL

SECTION PLAT

Location _____

Rig up _____

Drilling and Remarks:

Cor & 3360 corrected
7" @ 3360
500 acid
Depthograph &
30102
Max 3000

RECORD

Cased _____ in., _____ ft.

Sand _____

Gas _____

Oil _____

Total Depth 3368

PRODUCTION

1st 24 hrs. Nat. _____

1st 24 hrs. after shot _____

Gas _____ Cu. Ft.

Dry Hole _____

Abandoned _____

Date

JUL 2 1940₁₉

S. J. LEWIS Scout