

# KANSAS

Form 51-5M-7-39-Palace


Ellis

Section 13 Township 11 Range 18-W

Well No. #3 Hadley "B&C"

Company Darby Petroleum

NORTH Burnett Pool

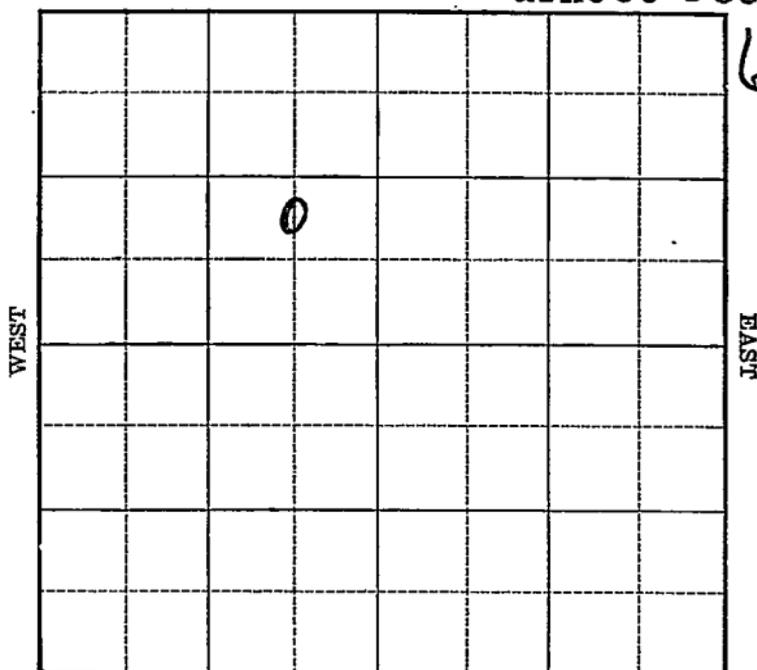

SOUTH

Sec. 13 Twp. 11 R. 18-W

Well No. #3 Hadley "B & C" Farm

Darby Petr. Company


(Bumett)

\_\_\_\_\_ Ft. from N. Line

990 Ft. from S. Line

660 Ft. from E. Line

\_\_\_\_\_ Ft. from W. Line

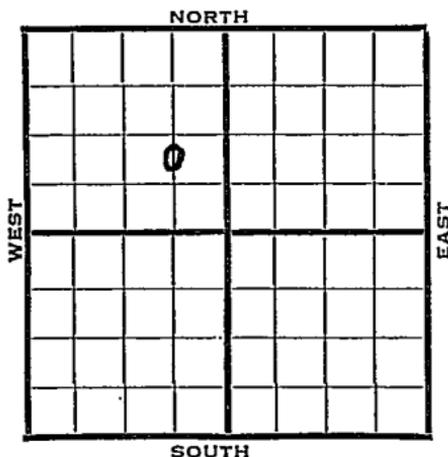

**Elev. 1865**

1940	REPORT
3/27	Derrick.
4/4	Surface hole.
4/12	15" - 102' <b>Ang.</b> 1097' 10" - 1102' <b>Drlg.</b> 2000'
4/18	Arb. 3342 $\frac{1}{2}$ ' <b>T.D.</b> 3343' 7" - 3342 $\frac{1}{2}$ ' <b>RUST.</b>
4/24	Arb. 3342 $\frac{1}{2}$ ' 7" - 3342 $\frac{1}{2}$ ' <b>T.D.</b> 3349'
	500 acid. Depthograph potential 112429 bbls
	Maximum 3000 bbls.
	<b>COMPLETED</b>

Map No. 7/ Sec. 13 Twp. 11 R. 18WWell No. 3 Hadley "B & C"Darby Petroleum Company

Contractor

**FIRST REPORT****SECTION PLAT****C N L SE NW**

\_\_\_\_\_ Ft. from N. Line

990 Ft. from S. Line660 Ft. from E. Line

\_\_\_\_\_ Ft. from W. Line

	o		

**BURNETT POOL**

Location \_\_\_\_\_

Rig up \_\_\_\_\_

Drilling and Remarks:

**Derrick****RECORD**

Cased \_\_\_\_\_ in., \_\_\_\_\_ ft.

Sand \_\_\_\_\_

Gas \_\_\_\_\_

Oil \_\_\_\_\_

Total Depth \_\_\_\_\_

**PRODUCTION**

1st 24 hrs. Nat. \_\_\_\_\_

1st 24 hrs. after shot \_\_\_\_\_

Gas \_\_\_\_\_ Cu. Ft.

Dry Hole \_\_\_\_\_

Abandoned \_\_\_\_\_

Date

MAR 27 1940 19S. J. LEWIS Scout

Map No. 71 Sec. 13 Twp. 11 R. 18W

Well No. 3 Hadley "B & C"

Darby Petroleum Company

Contractor

**COMPLETED**

C N L SE NW

\_\_\_\_\_ Ft. from N. Line

990 Ft. from S. Line

660 Ft. from E. Line

\_\_\_\_\_ Ft. from W. Line

**BURNETT POOL**

**SECTION PLAT**

	o		

Location \_\_\_\_\_

Rig up \_\_\_\_\_

Drilling and Remarks:

*Cr & 3342 1/2*  
*7" @ 3342 1/2*  
*500 Acid*  
*Geophysical 112429*

*Maximum 3000*

**RECORD**

Cased \_\_\_\_\_ in., \_\_\_\_\_ ft.

Sand \_\_\_\_\_

Gas \_\_\_\_\_

Oil \_\_\_\_\_

Total Depth 3349

**PRODUCTION**

1st 24 hrs. Nat. \_\_\_\_\_

1st 24 hrs. after shot \_\_\_\_\_

Gas \_\_\_\_\_ Cu. Ft.

Dry Hole \_\_\_\_\_

Abandoned \_\_\_\_\_

Date

APR 24 1940 <sub>19</sub>

S. J. LEWIS Scout