

KANSAS

Form 51—5M—7-39—Palace
r


Ellis

Section 13 Township 11 Range 18-W

Well No. #7 Hendrick

Company Phillips

Burnett Arb.Pool
NORTH

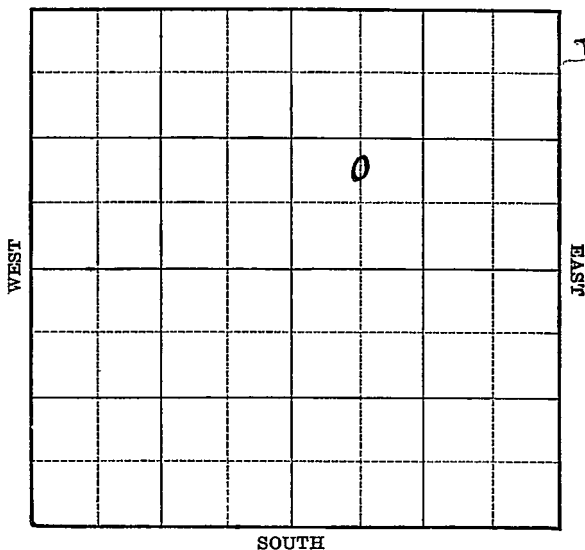

Sec. 13 Twp. 11 R. 18-W

Well No. #7 Hendrick Farm

Phillips _____ Company

(Burnett Arb.)


Ft. from N. Line

990 Ft. from S. Line

Ft. from E. Line

660 Ft. from W. Line

Elev. 1895

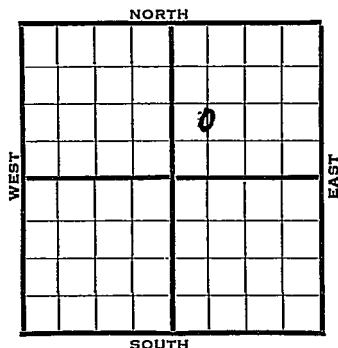[illegible]

Ellis

KANSAS

Map No. 71 Sec. 13 Twp. 11 R. 18WWell No. 7 HendrickPhillips

Company

Contractor

FIRST REPORT

C $N\frac{1}{2}$ SW NE Ft. from N. Line990 Ft. from S. Line Ft. from E. Line660 Ft. from W. Line

SECTION PLAT

		o	

BURNETT ARB. POOL

Location XRig up

Drilling and Remarks:

RECORD

Cased in., ft.Sand Gas Oil Total Depth

PRODUCTION

1st 24 hrs. Nat. 1st 24 hrs. after shot Gas Cu. Ft.Dry Hole Abandoned

Date

MAR 20 1940

19

S. J. LEWIS

Scout

KANSAS Ellis

Map No. 71 Sec. 13 Twp. 11 R. 18WWell No. 7 HendrickPhillips

Company

Contractor

COMPLETED

C $N\frac{1}{2}$ SW NE

Ft. from N. Line

990

Ft. from S. Line

Ft. from E. Line

660

Ft. from W. Line

BURNETT ARB POOL

SECTION PLAT

		0	

Location

Rig up

Drilling and Remarks:

*Ar & 3269**4" @ 3233**4000 acid**Dipthograph Pot**3666**Maximum 3000*

RECORD

Cased _____ in., _____ ft.

Sand _____

Gas _____

Oil _____

Total Depth *3374*

PRODUCTION

1st 24 hrs. Nat. _____

1st 24 hrs. after shot _____

Gas _____ Cu. Ft.

Dry Hole _____

Abandoned _____

Date

MAY 2 1930

S. J. LEWIS

Scout