

# KANSAS

Form 51-5M-11-38-Palace


Ellis

Section 13 Township 11 Range 18-W

Well No. #4 Hendrick

Company Phillips

NORTH Peavey Pool

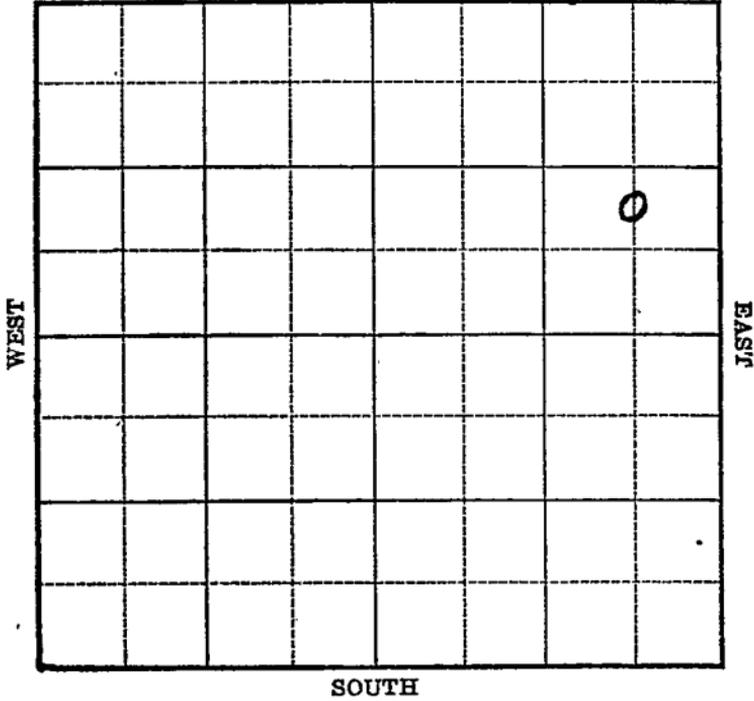

8



Map No. \_\_\_\_\_ Sec. 13 Twp. 11 R. 18W

Well No. 4 Hendrick

Phillips Company

Contractor

**FIRST REPORT  
C N L S E NE**

**SECTION PLAT**

\_\_\_\_\_ Ft. from N. Line

990 Ft. from S. Line

660 Ft. from E. Line

\_\_\_\_\_ Ft. from W. Line

			o

**PEAVEY POOL**

Location X

Rig up \_\_\_\_\_

Drilling and Remarks: \_\_\_\_\_

**RECORD**

Cased \_\_\_\_\_ in., \_\_\_\_\_ ft.

Sand \_\_\_\_\_

Gas \_\_\_\_\_

Oil \_\_\_\_\_

Total Depth \_\_\_\_\_

**PRODUCTION**

1st 24 hrs. Nat. \_\_\_\_\_

1st 24 hrs. after shot \_\_\_\_\_

Gas \_\_\_\_\_ Cu. Ft.

Dry Hole \_\_\_\_\_

Abandoned \_\_\_\_\_

Date

SEP 16 1935 19

S. J. LEWIS Scout

Map No. \_\_\_\_\_ Sec. 13 Twp. 11 R. 18WWell No. 4 HendrickPhillips

Company

Contractor

**COMPLETED****C N L SE NE**

\_\_\_\_\_ Ft. from N. Line

990 Ft. from S. Line660 Ft. from E. Line

\_\_\_\_\_ Ft. from W. Line

**SECTION PLAT**

			o

**PEAVEY POOL**

Location \_\_\_\_\_

Rig up \_\_\_\_\_

Drilling and Remarks:

*Cost 3357**5" c 3357**Echometer P 8**12583**Maximum 3500***RECORD**

Cased \_\_\_\_\_ in., \_\_\_\_\_ ft.

Sand \_\_\_\_\_

Gas \_\_\_\_\_

Oil \_\_\_\_\_

Total Depth 3360**PRODUCTION**

1st 24 hrs. Nat. \_\_\_\_\_

1st 24 hrs. after shot \_\_\_\_\_

Gas \_\_\_\_\_ Cu. Ft.

Dry Hole \_\_\_\_\_

Abandoned \_\_\_\_\_

Date

OCT 25 1939 19

Scout