

Sec. 13 Twp. 11 R. 18-W

Well No. #3 Peavey Farm _____

Phillips Company _____

(Bemis)


330 Ft. from N. Line

_____ Ft. from S. Line

660 Ft. from E. Line

_____ Ft. from W. Line

Elev. 1858

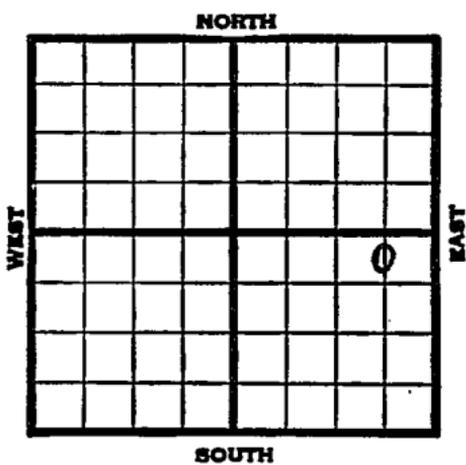

1939	REPORT
11/1	Location
11/9	Anhy 1090' 8" - 1090'
	Drlg. 1609'
11/16	Drlg. 2792'
11/23	Lans. 3027' Arb. 3330'
	T.D. 3332' Run 5".
11/29	5" - 3329' RUST.
12/7	Coring 3332' 2880' oil.
12/13	Arb. 3330'
	5" - 3329'
	T.D. 3332'
	Depthograph potential 7332 bbls.
	Maximum 3000 bbls.
	COMPLETED

Map No. 71 Sec. 13 Twp. 11 R. 18WWell No. 3 PeaveyPhillips

Company

Contractor

FIRST REPORT

C $N\frac{1}{2}$ NE SE330 Ft. from N. Line Ft. from S. Line660 Ft. from E. Line Ft. from W. Line

SECTION PLAT

			o

BEMIS POOL

Location XRig up

Drilling and Remarks: *

RECORD

Cased in., ft.Sand Gas Oil Total Depth

PRODUCTION

1st 24 hrs. Nat. 1st 24 hrs. after shot Gas Cu. Ft.Dry Hole Abandoned

Date

NOV 1 1939 19S. J. LEWIS Scout

Ellis

Map No. 71 Sec. 13 Twp. 11 R. 18W

Well No. 3 Peavey

Phillips Petroleum Company

Contractor

COMPLETED

C $N\frac{1}{2}$ NE SE

330 Ft. from N. Line

_____ Ft. from S. Line

660 Ft. from E. Line

_____ Ft. from W. Line

SECTION PLAT

			o

BEMIS POOL

Location _____

Rig up _____

Drilling and Remarks:

Oil @ 3330

5" @ 3329

*Depthograph 38
7332*

Maximum 3000

RECORD

Cased _____ in., _____ ft.

Sand _____

Gas _____

Oil _____

Total Depth 3332

PRODUCTION

1st 24 hrs. Nat. _____

1st 24 hrs. after shot _____

Gas _____ Cu. Ft.

Dry Hole _____

Abandoned _____

Date

DEC 13 1939 19

S. J. LEWIS Scout