

KANSAS

Ellis


Form 51-5M-7-39-Palace

Section 13 Township 11 Range 18-W

Well No. #4 Peavey

Company Phillips

NORTH Burnett Arb. Pool

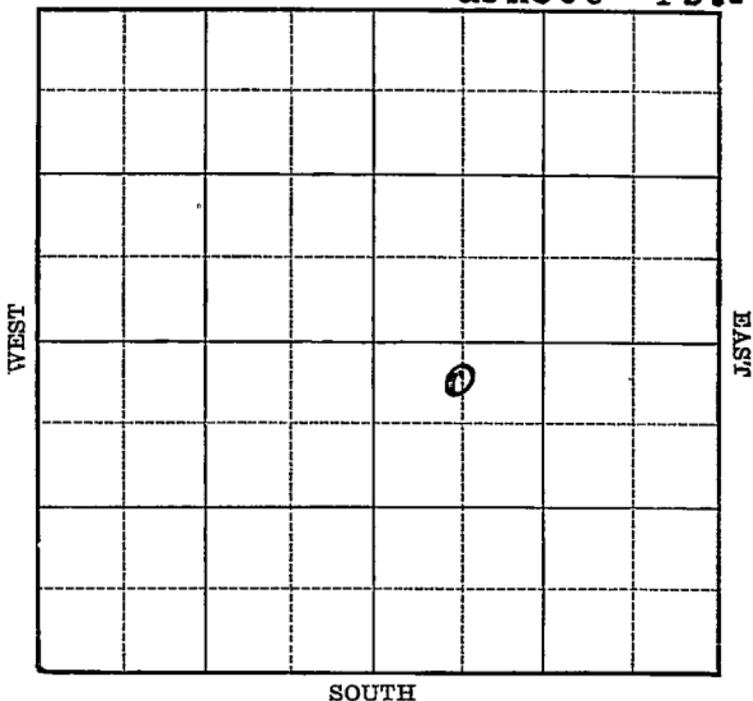

10

Sec. 13 Twp. 11 R. 18-W

Well No. #4 Peavey Farm _____

Phillips Company _____

(Burnett Arb.)


330 Ft. from N. Line

_____ Ft. from S. Line

_____ Ft. from E. Line

660 Ft. from W. Line

Elev. 1912

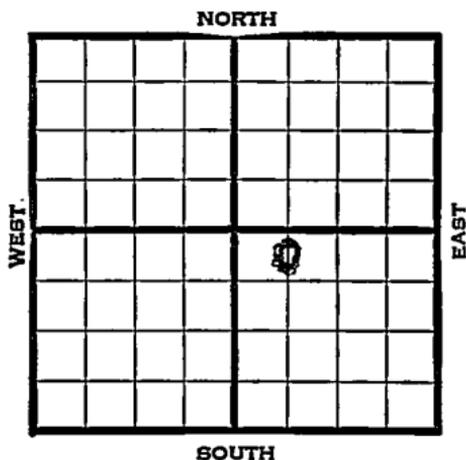

1940	REPORT
5/8	Pits.
5/16	Anhy 1140' Drlg. 1148'
5/23	8" - 1148' Drlg. 2715'
5/29	Lans. 3089' Arb. 3383' 3383' 91' T.D. Run pipe.
6/6	Arb. 3383' (Corrected)
	5" - 3383' T.D. 3387' 2900' oil.
6/12	Arb. 3383'
	5" - 3383'
	T.D. 3387'
	Echometer potential 23,115 bbls.
	Maximum 3000 bbls.
	COMPLETED

Map No. 71 Sec. 13 Twp. 11 R. 18WWell No. 4 PeaveyPhillips

Company

Contractor

FIRST REPORT

SECTION PLAT

C $N\frac{1}{2}$ NW SE
330 Ft. from N. Line

_____ Ft. from S. Line

_____ Ft. from E. Line

660 Ft. from W. Line

		o	

BURNETT ARB. POOL

Location _____

Rig up _____

Drilling and Remarks:

Pits

RECORD

Cased _____ in., _____ ft.

Sand _____

Gas _____

Oil _____

Total Depth _____

PRODUCTION

1st 24 hrs. Nat. _____

1st 24 hrs. after shot _____

Gas _____ Cu. Ft.

Dry Hole _____

Abandoned _____

Date

MAY 8 1940₁₉

S. J. LEWIS

Scout

Map No. 71 Sec. 13 Twp. 11 R. 18W

Well No. 4 Peavey

Phillips Company

Contractor

COMPLETED

C N $\frac{1}{2}$ NW SE

330 Ft. from N. Line

_____ Ft. from S. Line

_____ Ft. from E. Line

660 Ft. from W. Line

SECTION PLAT

		0	

BURNETT ARB. POOL

Location _____

Rig up _____

Drilling and Remarks:

Co # 3383

5" @ 3383

Echometer # 8

23115

W of 3000

RECORD

Cased _____ in., _____ ft.

Sand _____

Gas _____

Oil _____

Total Depth 2387

PRODUCTION

1st 24 hrs. Nat. _____

1st 24 hrs. after shot _____

Gas _____ Cu. Ft.

Dry Hole _____

Abandoned _____

Date

JUN 12 1940

S. J. LEWIS Scout