


Section 13 Township 11 Range 21 W

Well No. # 6 O'Conner

Company Continental Oil

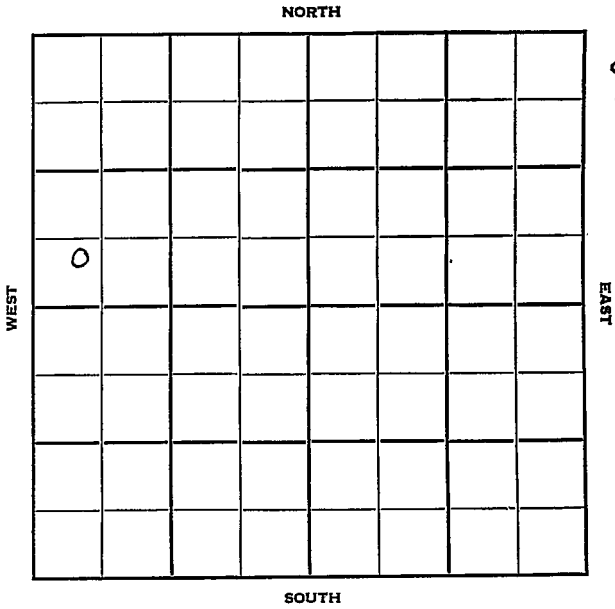

Trego **KANSAS**

Sec. 13 Twp. 11 R. 21W ✓

Well No. #6 O'Conner Farm

Continental Oil Company

Walz Pool Contractor


Ft. from N. Line

440' Ft. from S. Line

Ft. from E. Line

440' Ft. from W. Line

SW SW NW

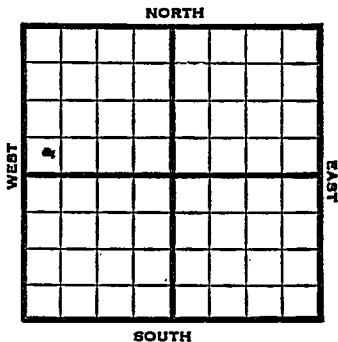

1951 Elev. 2140' REPORT

4/25	Cellar & Pits
10/17	Abandoned Location
	ABANDONED

County Trego State Kansas

Sec. 13 (Blk. 11) (Sur. 21W) (Twp.) (Rge.) Map No.

Operator Continental Oil

Well No. 6 Farm D¹Conner

Elev. Location SW SW NW

FIRST REPORT									
0									

440 Ft. From S Line NW

440 Ft. From W Line Quarter

Ist. Report APR 25 1951

Completion _____

Remarks _____

Spudding Date _____

Drlg. Data Walz Pool

Cellar & pits

