

Trego

KANSAS

SEC.	TWP.	R.
13	11	21 W

WELL NO.

3 O'Connor "A"

FARM

COMPANY

Continental Oil

CONTRACTOR

Lohman & Johnson

Walz Pool


990 Ft. from N. Line

Ft. from S. Line

Ft. from E. Line

330 Ft. from W. Line

SW NW SW

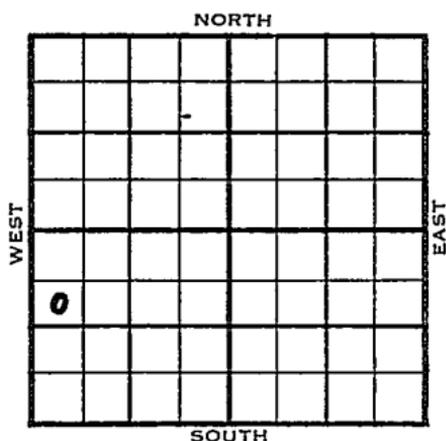

	ELEVATION	REPORT
1953	2143'	

9/23

EUR

9/30

10" @ 209' w/125 sks
Drig 3373'

11/4

Spud 9-22-53 Oil well TD 3734
 10" @ 309 Heeb 3384 Tor. 3409
 Lans. 3424
 DST 3449-70 open 3/4 hr. rec 15' mud
 1880#
 DST 3504-18 open 1 hr rec 30' mud
 1130# B KC 3647 Cong. 3680
 DST 3719-24 open 1/2 hr rec 10' mud O#
 Arb. 3724'
 DST 3720-29 open 1 hr rec 60' mud O#
 DST 3721-34 open 3/4 hr rec 30' mud
 450# TD 3734 5" @ 3725
 CO to 3734 A-frac. S/110 BO 27 BW
 24 hrs. S/3 BO 1 BWPH 7 hr.
 P/4 1/2 BW 4 BOPH
 Comp. 86 BOPD 22 BW

COMPLETED

County Trego State Kansas

Sec. 13 (Blk. Twp.) 11 (Sur. Rge.) 21W Map No.

Operator Continental Oil

Well No. 3 Farm O'Connor "A"

Elev. Location SW NW SW

990 Ft. From N Line SW

330 Ft. From W Line Quarter

1st. Report SEP 23 1953

Completion _____

Remarks _____

Lohman & Johnson - Contr.

Spudding Date _____

Drlg. Data Walz Pool

R T R

FIRST REPORT

