
FORM 51 25M 3-49 PETROL Trego KANSAS

Section 13 Township 11 Range 21W

Well No. #2 O'Conner "A"

Company Continental Oil

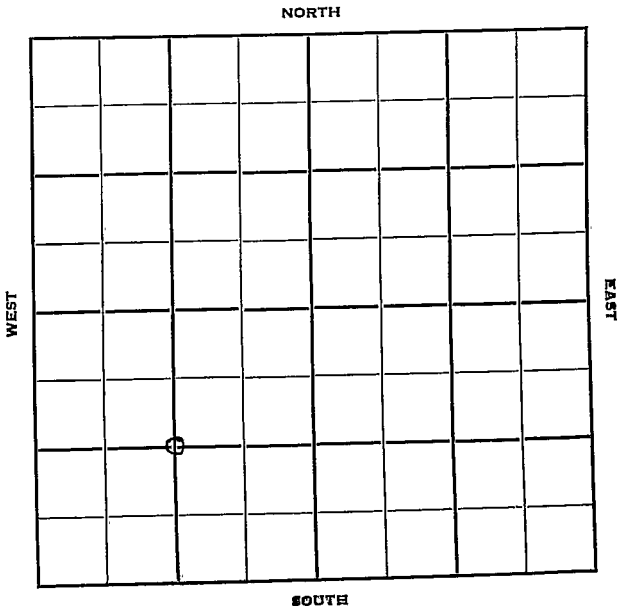

FORM 252-B
10M 11-50 PETROL

Trego

KANSAS

Sec. 13 Twp. 11 R. 21 W

Well No. # 2 O'Conner "A" Farm

Continental Oil Company

Contractor

Walz Pool


Ft. from N. Line

1320 Ft. from S. Line

Ft. from E. Line

1320 Ft. from W. Line

C SW/4

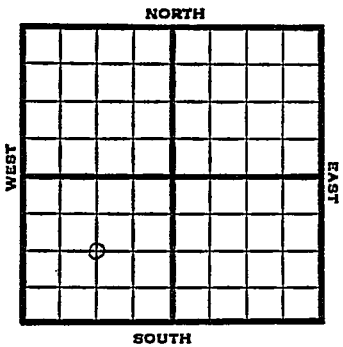

1951	Elev. 2128' REPORT
8/15	Spud 8-13-51 10" @ 216 WOC
8/29	Spud 8-13-51 D&A TD 3782 10" @ 216 Heeb. 3373 Tor. 3395 KC 3413 Cong. 3601 Arb. 3739-82 TD D&A

ABANDONED

FORM 275 FOR SALE BY KANSAS BLUE PRINT CO.


County Trego State Kansas

Sec. 13 (Blk. Twp.) 11 (Sur. Rge.) 21W Map No.

Operator Continental Oil

Well No. 2 Farm O'Conner "A"

Elev. Location C SW/4

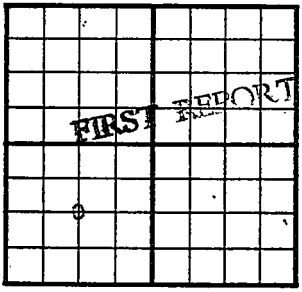

1320 Ft. From S Line SW

1320 Ft. From W Line Quarter

1st. Report AUG 1 5 1951

Completion

Remarks

Spudding Date 8-13-51

Drlg. Data Walz Pool

10" @ 216 WOC

J. E. TYRA

FORM 275 FOR SALE BY KANSAS BLUE PRINT CO.


County Trego State Kansas

Sec. 13 (Blk. Twp.) 11 (Sur. Rge.) 21W Map No.

Operator Continental Oil

Well No. 2 Farm O'Conner "A"

Elev. 2128 Location C SW/4

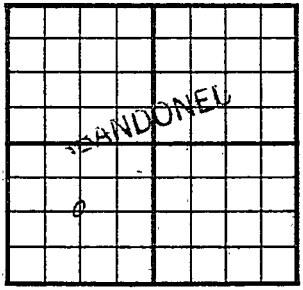

1320 Ft. From S Line SW

1320 Ft. From W Line Quarter

1st. Report

Completion AUG 2 9 1951

Remarks Walz Pool

Spudding Date 8-13-51

Drlg. Data D & A TD 3782

10" @ 216 Heeb. 3373 Tor. 3395

KC 3413 Cong. 3601 Arb. 3739-82 TD

D & A

J. E. TYRA