


Section 13 Township 11 Range 21W

Well No. #1 O'Connor

Company Continental

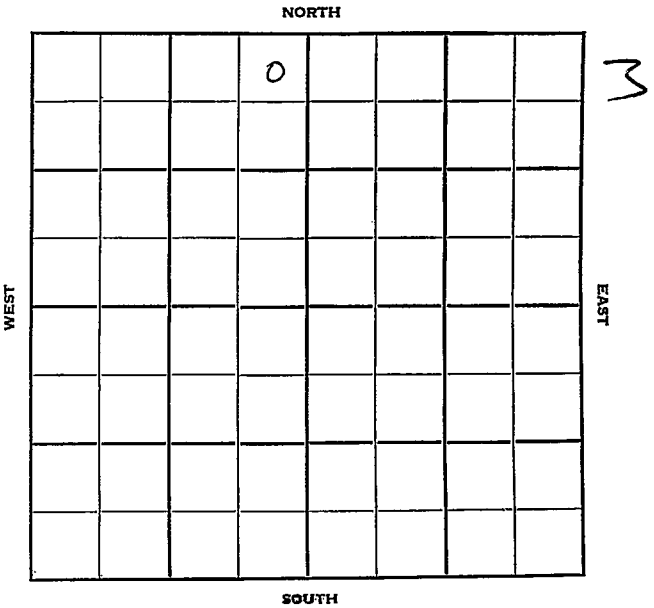

Sec. 13 Twp. 11 R. 21W

Well No. #1 O'Connor Farm

Continental Company

Lohman & Johnson Contractor

Walz Pool


330' Ft. from N. Line

_____ Ft. from S. Line

330' Ft. from E. Line

_____ Ft. from W. Line

NE NE NW

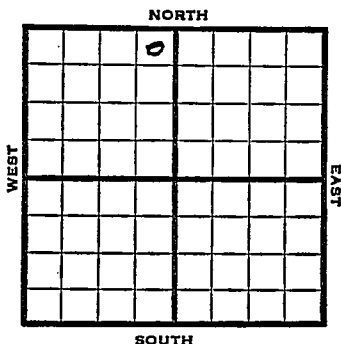

1951 Elev. 2096' REPORT

1/24 Spud 1-20-51
10" @ 215'
Drlg. 1180'

3/7 Spud. 1-20-51
Oil Well TD 3678
10" @ 215'
Heeb. 3331' Toronto 3352
Lans. 3368 Arb. 3662
6" @ 3663 TD 3676
S/2 boph 1000 A S/5 boph
DD 3678 S/11 boph 500 A
Comp. 423 bopd

COMPLETED

County **Trego** State **Kansas**

Sec. **13** (Blk.) **11** (Sur.) **21W** Map No.

Operator **Continental**

Well No. **1** Farm **O'Connor**

Elev. **2096** Location **NE NE NW**

		0					

330 Ft. From **N** Line **NW**

330 Ft. From **E** Line **Quarter**

1st. Report **JAN 24 1951**

Completion

Remarks

Lohman & Johnson

Spudding Date **1-20-51**

Drlg. Data **Walz Pool**

10" @ 215 drlg. 1180

J. E. TYRA

County Trego State Kansas

Sec. 13 (Blk. 11 (Sur. 21W (Twp.) 11 (Rge.) 21W Map No.

Operator Continental

Well No. 1 Farm O'Connor

Elev. 2096 Location NE NE NW

		o			
		COMPLETE			

330 Ft. From N Line NW

330 Ft. From E Line Quarter

Ist. Report

Completion MAR 7 1951

Remarks Walz Pool

Lohman & Johnson - Contr.

Spudding Date 1-20-51

Drlg. Data Oil well TD 3678

10" @ 215 Heeb. 3331 Toronto 3352

Lans. 3368 Arb. 3662 6" @ 3663 TD 3676

S/ 2 boph 1000 A S/ 5 boph DD 3678

S/ 11 boph 500 A Comp. 423 bopd