

Company Amerada Pet.

WEST

EAST

ROUTH

Trego

Sec. 13 Twp. 11 R. 23W

Well No. #1 Carpenter Farm

Amerada. Pet. Company

Peel Drlg. Contractor

Wakeeney Pool


330' Ft. from N. Line

 Ft. from S. Line

990' Ft. from E. Line

 Ft. from W. Line

NW NE NW

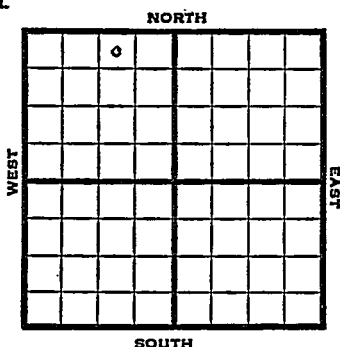

1951

Elev. 222h' REPORT

6/6

RUR

7/3

Spud 6-8-51

D & A TD 4004' 8" @ 202

Top 3199' Heeb 3421' Lans 3457'

DST 3495-3539' open 2 hr. rec 1690' wtr
SSO

DST 3624-3715' open 2 hr. rec 150' mud


TD 4004' Arb. 3953' D & A

Schlm tops: Top 3243', Heeb 3457',

Br. lime 3493', B KC 3723', Cong 3989'


Arb. 3960'

ABANDONED

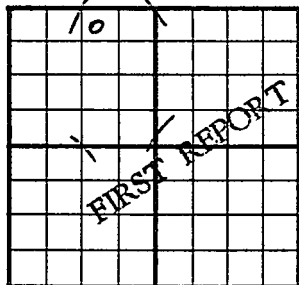County Trego State KansasSec. 13 (Blk. 11 (Sur. 23W Map No. 11 (Twp. 11 (Rge. 23W)Operator Amerada Pet.Well No. 1 Farm CarpenterElev. Location NW NE NW330 Ft. From N Line NW990 Ft. From E Line Quarter1st. Report JUN 6 1951Completion Remarks B & R DHMMCPC has NE of 24
Peel Drig. - Contr.Spudding Date Drig. Data Wakeeney PoolR U R

J. E. TYRA

County Trego State Kansas
 Sec. 13 (Blk.) 11 (Sur.) 23W Map No.
 Operator Amerada Pet.
 Well No. 1 Farm Carpenter
 Elev. 2224 Location NW NE NW

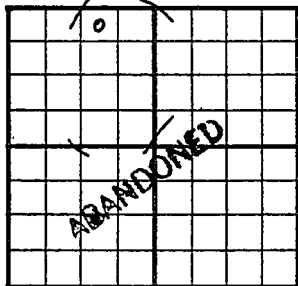

330 Ft. From N Line NW
990 Ft. From E Line Quarter

1st. Report

Completion JUL 3 1951

Remarks Wakeeney Pool

Peel Drlg. - Contr.

Spudding Date 6-8-51

Drlg. Data D & A TD 4004

8" @ 202 Top. 3199 Heeb. 3421

Trans. 3457 DST 3495-3539 open 2 hr.

Rec. 1690' water SSO DST 3624-3715

open 2 hr. Rec. 150' mud TD 4004

Arb. 3953 D & A

SCHLUMBERGER TOPS

Top. 3243 Heeb. 3457 Br. lime 3493

B KC 3723 Cong. 3898 Arb. 3960

J. E. TYRA