

KANSAS

Ellis

Form 51—5M—7-40—Palace


Section 13 Township 11 Range 18-W

Well No. 5 Hadley "B"

Company Darby

Burnett Pool

NORTH

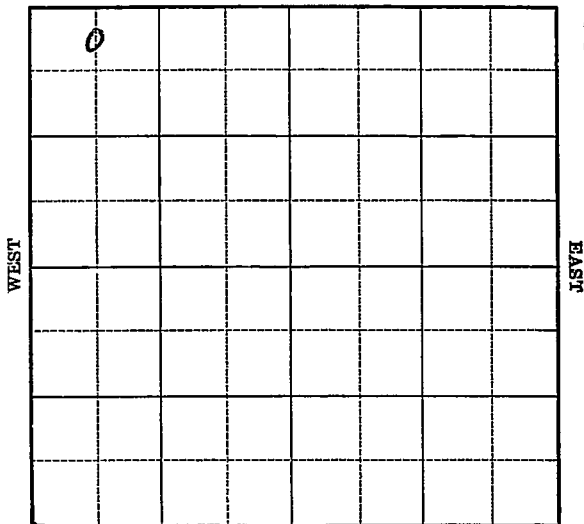

SOUTH

KANSAS

Ellis

Sec. 13 Twp. 11 R. 18-WWell No. #5 Hadley "B" FarmDarby

Company

(Burnett)


330 Ft. from N. Line

Ft. from S. Line

Ft. from E. Line

660 Ft. from W. Line

Elev. 1863

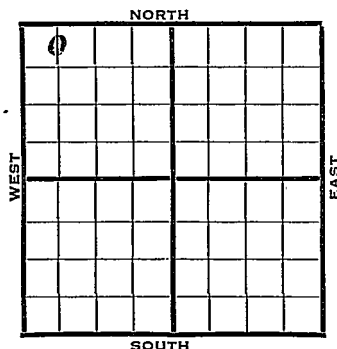

1941

REPORT

1/29

Derrick.

2/6

15" - 90' WOC.

2/13

Anhy 1101' 10" - 1105' WOC.

2/20

Drlg. 3174'

2/26

Simp. 3332' Arb. 3358'

7" - 3358' T.D. 3365'

3000' oil 13 hrs. 500 acid.

3/5

Arb. 3358'

7" - 3358'

T.D. 3365'

500 acid.

Depthograph potential 3750 bbls.

Maximum 3000 bbls.

32. Gravity

COMPLETED

Map No. 7/ Sec. 13 Twp. 11 R. 18WWell No. 5 Hadley "B"Darby Petroleum CompanyCOMPLETED Contractor

C N L NW NW

SECTION PLAT

330 Ft. from N. Line Ft. from S. Line Ft. from E. Line660 Ft. from W. Line

BURNETT POOL

0			

Location Rig up

Drilling and Remarks:

At 8.3358
7" @ 3358.
500 acid
Depth 883750
Nov 2000
32° Gr.

RECORD

Cased in., ft.Sand Gas Oil Total Depth 3365

PRODUCTION

1st 24 hrs. Nat. 1st 24 hrs. after shot Gas Cu. Ft.Dry Hole Abandoned

Date

MAR 5 1941 19 S. J. LEWIS Scout