

Ellis


KANSAS

FORM 51 5M 2-38 TPCO.

Section 13 Township 11 Range 17-W

Well No. 4 Cress

Company Sinclair-Prairie

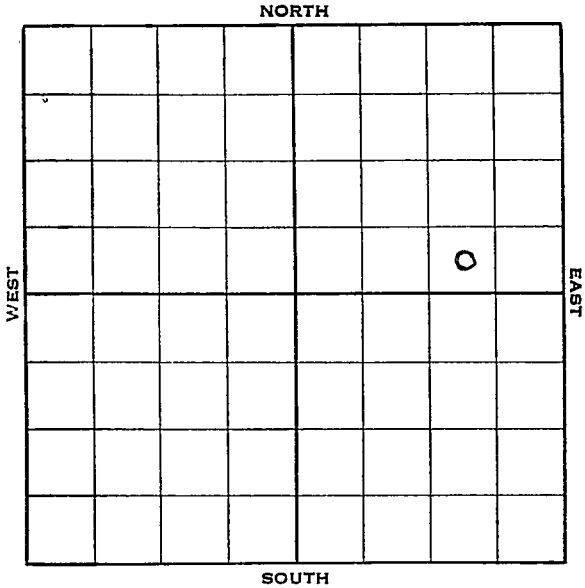

Sec. 13 Twp. 11 R. 17

Well No. #4 Cress Farm

Sinclair-Prairie Company


\_\_\_\_\_ Ft. from N. Line

330 Ft. from S. Line

990 Ft. from E. Line

\_\_\_\_\_ Ft. from W. Line

Elev. 1831

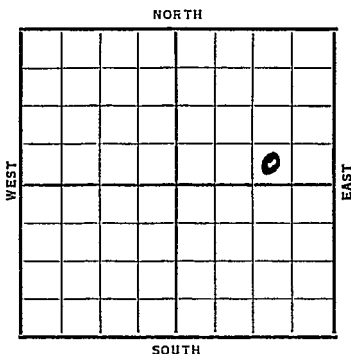

Date	REPORT
1938	
2/9	Dig cellar.
2/18	R. R.
2/26	16" @ 90'. WOC.
3/4	Anhy 1015'. 10" @ 1026'. Drlg. 2050'.
3/11	Drlg. 3100'.
3/18	Arb. 3353'. T.D. 3355' S.O. RUST.
3/23	5 1/2" @ 3353'. Arb. 3353'. T.D. 3355'. 2000 acid. Potential 1050 bbls.
<b>COMPLETED</b>	

Map No. 71 Sec. 13 Twp. 11 R. 17WWell No. 4 CressSinclair Prairie Company

Contractor

**FIRST REPORT**

SW SE NE

\_\_\_\_\_ Ft. from N. Line

330 Ft. from S. Line990 Ft. from E. Line

\_\_\_\_\_ Ft. from W. Line

**SECTION PLAT**

			0

Location \_\_\_\_\_

Rig up \_\_\_\_\_

Drilling and Remarks:

**Dig Cellar****RECORD**

Cased \_\_\_\_\_ in., \_\_\_\_\_ ft.

Sand \_\_\_\_\_

Gas \_\_\_\_\_

Oil \_\_\_\_\_

Total Depth \_\_\_\_\_

**PRODUCTION**1st 24 hrs. ~~Net~~ \_\_\_\_\_

1st 24 hrs. after shot \_\_\_\_\_

Gas \_\_\_\_\_ Cu. Ft.

Dry Hole \_\_\_\_\_

Abandoned \_\_\_\_\_

Date

FEB 9 . 1938 19

H. D. Hatfield Scout

Map No. 71 Sec. 13 Twp. 11 R. 17WWell No. 4 CressSinclair Prairie

Company

Contractor

**COMPLETED****SECTION PLAT**

SW SE NE

     Ft. from N. Line330 Ft. from S. Line990 Ft. from E. Line     Ft. from W. Line

			0

Location     Rig up     

Drilling and Remarks:

*2000 acid**Pot 1050***RECORD**Cased 5 1/2 in., 3353 ft.Sand A-6 3353Gas     Oil     Total Depth 3355**PRODUCTION**1st 24 hrs. Nat.     1st 24 hrs. after shot     Gas      Cu. Ft.Dry Hole     Abandoned     Date  
MAR 23 1938

H. D. Hatfield

19

Scout