


Section 13 Township 11 Range 17-W

Well Number #3 Cress

Company Sinclair-Prairie

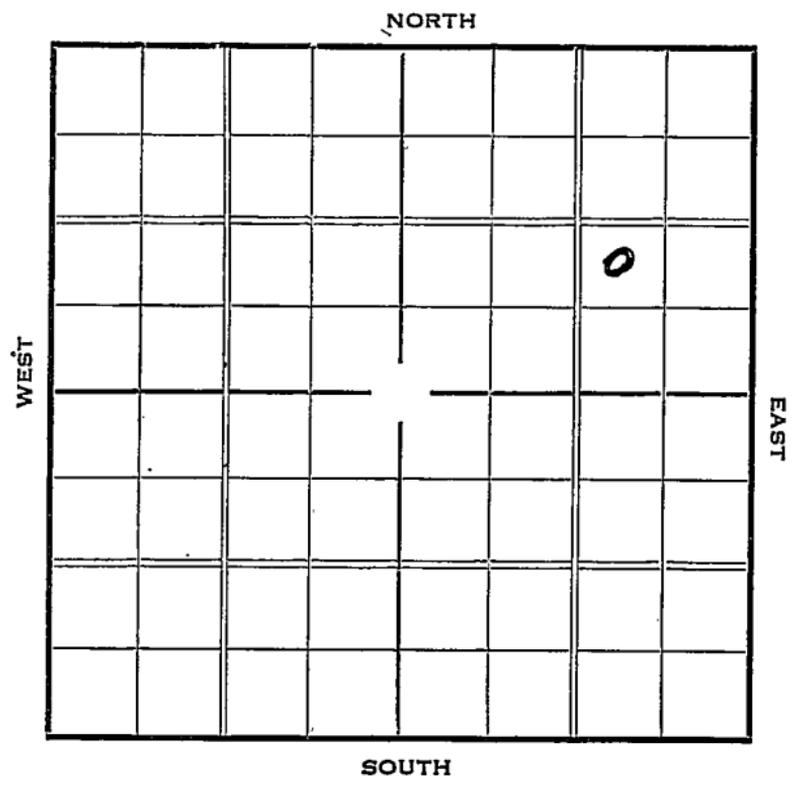

Sec. 13 Twp. 11 R. 17-W

Well No. #3 Gress Farm \_\_\_\_\_  
Sinclair Prairie Company \_\_\_\_\_


\_\_\_\_\_ Ft. from N. Line

990 Ft. from S. Line

990 Ft. from E. Line

\_\_\_\_\_ Ft. from W. Line

Elev. 1816

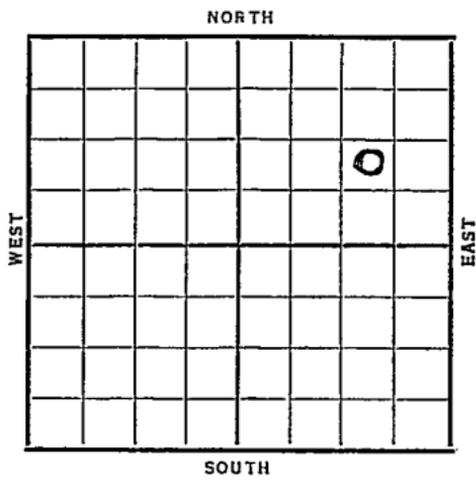

Date.	REPORT
1937	
10/13	Matl
10/22	R U R..
10/29	15" @ 100'. Anhy 995'.
	10" @ 1013'. WOC.
11/5	Drlg. 2754'.
11/12	Sil. <del>3332</del> <sup>3332</sup> @ 7" @ 3333'. T.D. 3338'.
	RUST. No shows. Rep.
11/19	Sil. <del>3341</del> <sup>3332</sup> 3332
	7" @ <del>3333</del> <sup>3333</sup> 3333'. (Corrected)
	T.D. 3348'. 3000' oil 24 hrs.
11/26	Sil. 3332' (Corrected)
	7" @ 3333g. (Corrected)
	2000 acid.
	Potential 4ll. Will retreat.
12/3	5000 acid.
	OVER

1937

12/8

7" @ 3333'.

Sil. 3332' (Corrected)

T.D. 3348'.

2000 acid.

5000 acid.

Potential 411 bbls.

COMPLETED

Ellis

Map No. \_\_\_\_\_ Sec. 13 Twp. 11 R. 17WWell No. 3 CressSinclair Prairie

Company \_\_\_\_\_

Contractor \_\_\_\_\_

## FIRST REPORT

NW SE NE

\_\_\_\_\_ Ft. from N. Line

990 Ft. from S. Line990 Ft. from E. Line

\_\_\_\_\_ Ft. from W. Line

## SECTION PLAT

			0

Location \_\_\_\_\_

Rig up \_\_\_\_\_

Drilling and Remarks:

Matl

## RECORD

Cased \_\_\_\_\_ in., \_\_\_\_\_ ft.

Sand \_\_\_\_\_

Gas \_\_\_\_\_

Oil \_\_\_\_\_

Total Depth \_\_\_\_\_

## PRODUCTION

1st 24 hrs. Nat. \_\_\_\_\_

1st 24 hrs. after shot \_\_\_\_\_

Gas \_\_\_\_\_ Cu. Ft.

Dry Hole \_\_\_\_\_

Abandoned \_\_\_\_\_

Date

OCT 13 1937 19H. D. Hatfield Scout

Ellis KANSAS

Map No. \_\_\_\_\_ Sec. 13 Twp. 11 R. 17W

Well No. 3 Cress

Sinclair Prairie Company

Contractor

**COMPLETED**

**SECTION PLAT**

NW SE NE

\_\_\_\_\_ Ft. from N. Line

990 Ft. from S. Line

990 Ft. from E. Line

\_\_\_\_\_ Ft. from W. Line

			0

Location \_\_\_\_\_

Rig up \_\_\_\_\_

**RECORD**

Cased 7 in., 3333 ft.

Sand 51 3332 (corrected)

Gas \_\_\_\_\_

Oil \_\_\_\_\_

Total Depth 3348

**PRODUCTION**

1st 24 hrs. Nat. \_\_\_\_\_

1st 24 hrs. after shot \_\_\_\_\_

Gas \_\_\_\_\_ Cu. Ft.

Dry Hole \_\_\_\_\_

Abandoned \_\_\_\_\_

Drilling and Remarks:

*2000 acid*  
*5000 ✓*

*POT-411*

Date

**DEC 8 - 1937** 19

**H. D. Hatfield** Scout