

KANSAS

Ellis

Section 13 Township 11 Range 17WWell No. 1 CressCompany W.H. Black et al

Bemis

NORTH

WEST

EAST

			0				

SOUTH

6

Ellis

KANSAS

Sec. 13 -Twp. 11 R. 17W

Well No. #1 Cress Farm

W. H. Black et al

Company

Bemis
Pool

(W. H. Black, Cont.)

NORTH


 Ft. from N. Line

330' Ft. from S. Line

330' Ft. from E. Line

 Ft. from W. Line

SE NW

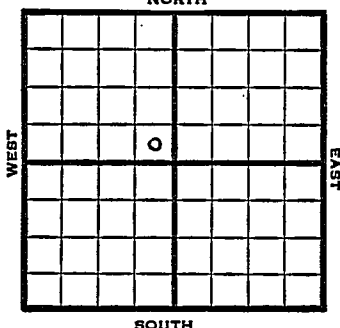

1949

Elev 1826'

REPORT

7/6

8" @ 560'

Drlg. 810'

7/13

TD 3380 In Cong

Lans 3017'

Cong 3310'

Aband.

ABANDONED

Map No. _____ Sec. 13 Twp. 11 R. 17W


Well No. 1 Cress

W. H. Black et al. _____ Company

W. H. Black _____ Contractor

SE NW

FIRST REPORT
SECTION PLAT

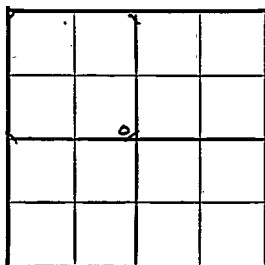

_____ Ft. from N. Line

330 _____ Ft. from S. Line

330 _____ Ft. from E. Line

_____ Ft. from W. Line

Ellis County

Location _____

Rig up _____

Drilling and Remarks:

8" @ 560

drlg. 810

RECORD

Cased _____ in., _____ ft.

Sand _____

Gas _____

Oil _____

Total Depth _____

PRODUCTION

1st 24 hrs. Nat. _____

1st 24 hrs. after shot _____

Gas _____ Cu. Ft.

Dry Hole _____

Abandoned _____

Date

JUL 6 1949 19 S. J. LEWIS Scout

Kansas

Map No. 471 Sec. 13 Twp. 11 R. 17WWell No. 1 Cress

W. H. Black et al.

Company


ABANDONED

Contractor

SE NW

E 1826

SECTION PLAT

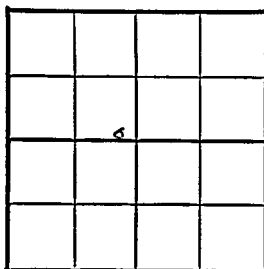

Ft. from N. Line

330

Ft. from S. Line

330

Ft. from E. Line

Ft. from W. Line

Ellis County

Location

Rig up

Drilling and Remarks:


RECORD

Cased _____ in., _____ ft.

Sand _____

Gas _____

Oil _____


PRODUCTION

1st 24 hrs. Nat. _____

1st 24 hrs. after shot _____

Gas _____ Cu. Ft.

Dry Hole _____

Abandoned _____

Date

JUL 13 1949 19S. J. LEWIS

Scout