


Section 13 Township 11 Range 17-W

Well No. 2 Pearl


Company Gulf

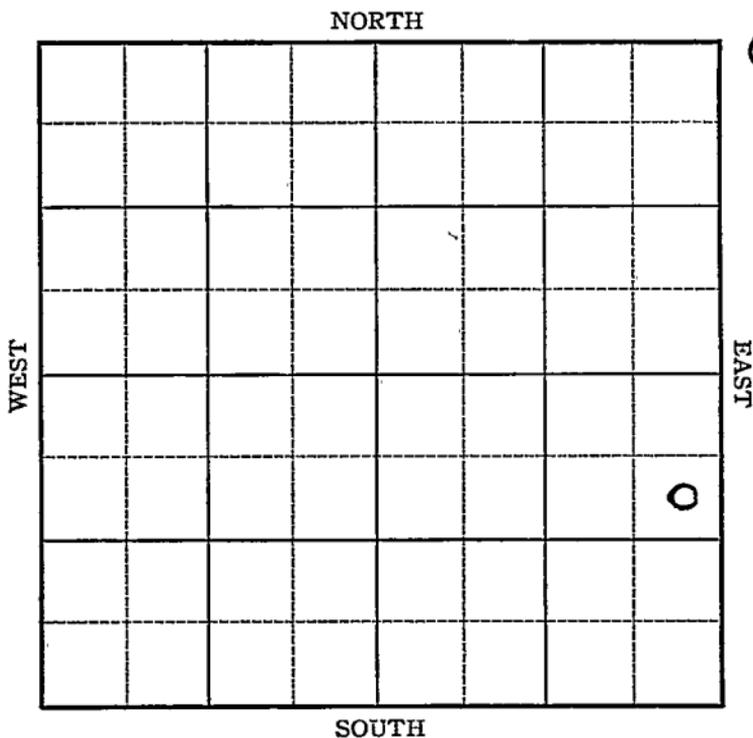

Sec. 13 Twp. 11 R. 17-W

Well No. #2 Pearl Farm _____
Gulf Company _____

990 Ft. from N. Line
 _____ Ft. from S. Line
330 Ft. from E. Line
 _____ Ft. from W. Line
Elev. 1883'

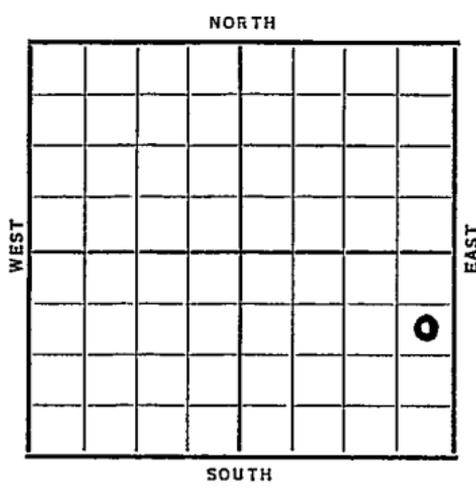

Date	REPORT
1938	
1/19	B.R.R.
1/28	16"-159' Drlg. 985'
2/4	Anhy 1080' 10" 1093'
	Drlg. 2210'
2/11	Drlg. 3200'.
2/18	Arb. 3387'. T.D. 3388'.
	6" @ 3388'. S.O. RUST.
2/26	T.D. 3392'. 2900' oil in 7 hrs.
3/2	6" @ 3387'.
	Arb. 3387'.
	T.D. 3392'.
	2000 acid.
	Potential 1935 bbls.
	COMPLETED

Map No. 71 Sec. 13 Twp. 11 R. 17WWell No: 2 PearlGulf

Company

Contractor

FIRST REPORT

SE NE SE

990 Ft. from N. Line Ft. from S. Line330 Ft. from E. Line Ft. from W. Line**SECTION PLAT**

			0

Location _____

Rig up _____

Drilling and Remarks:

BRR

RECORD

Cased _____ in., _____ ft.

Sand _____

Gas _____

Oil _____

Total Depth _____

PRODUCTION

1st 24 hrs. Nat. _____

1st 24 hrs. after shot _____

Gas _____ Cu. Ft.

Dry Hole _____

Abandoned _____

Date

JAN 19 1938 19H. D. Hatfield Scout

Map No. _____ Sec. 13 Twp. 11 R. 17W

Well No. 2 Pearl

Gulf Company

Contractor _____

COMPLETED

SECTION PLAT

SE NE SE

990 Ft. from N. Line

_____ Ft. from S. Line

330 Ft. from E. Line

_____ Ft. from W. Line

			0

Location _____

Rig up _____

Drilling and Remarks:

2000 acid

POT 1935

RECORD

Cased 6 in., 3387 ft.

Sand Arb 3387

Gas _____

Oil _____

Total Depth 3392

PRODUCTION

1st 24 hrs. Nat. _____

1st 24 hrs. after shot _____

Gas, _____ Cu. Ft.

Dry Hole _____

Abandoned _____

Date

MAR 2 - 1938 19

H. D. Hatfield Scout