

KANSAS

Form 51-5M-7-39-Palace


Ellis

Section 13 Township 11 Range 17-W

Well No. #2 Cress

Company Frank Hollow

NORTH Bemis Pool

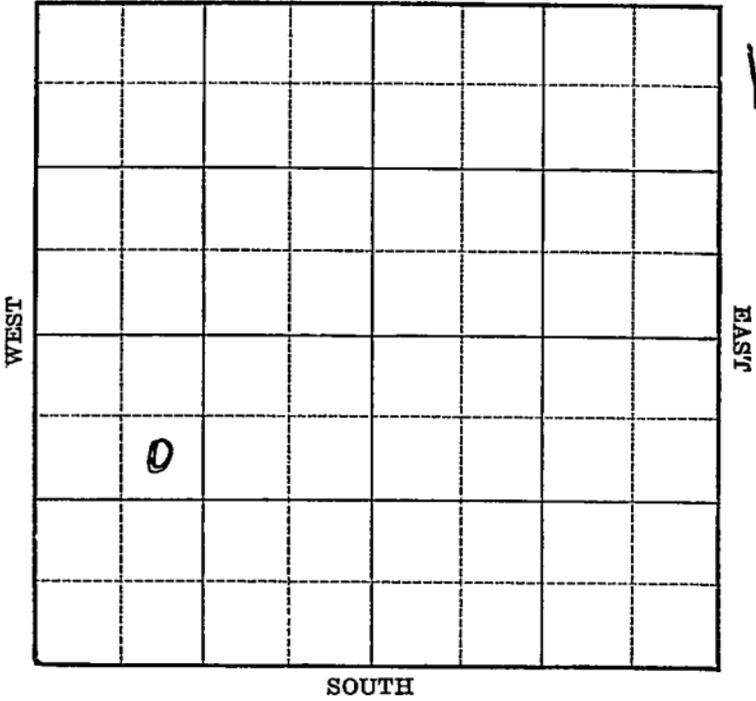

12

Sec. 13 Twp. 11 R. 17-W

Well No. #2 Cress Farm
Frank Hollow Company


(Bemis)

990 Ft. from N. Line

_____ Ft. from S. Line

_____ Ft. from E. Line

990 Ft. from W. Line

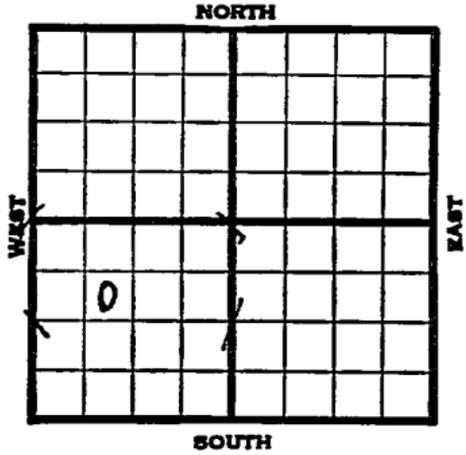

Elev. 1846

1939		REPORT
10/4		Pits.
10/12	15" - 90'	Drlg. 1000'
10/19	Anhy 1045' 8" - 1055'	
		Drlg. 2807'
10/26	Lans. 3062' Arb. 3366'	
	5 1/2" - 3367' T.D. 3371'	RUST.
11/2	Swab 1200 bbls. 24 hours.	
	1500 acid. Testing.	
11/8	Arb. 3366'	
	5 1/2" - 3367'	
	T.D. 3372'	
	1500 acid.	
	Echometer potential 2530 bbls.	
COMPLETE		

Map No. _____ Sec. 13 Twp. 11 R. 17W

Well No. 2 Cress

Frank Hollow

Company

Contractor

FIRST REPORT
SE NW SW

SECTION PLAT

990 Ft. from N. Line

_____ Ft. from S. Line

_____ Ft. from E. Line

990 Ft. from W. Line

BEMIS POOL

Location _____

Rig up _____

Drilling and Remarks:

Pits

RECORD

Cased _____ in., _____ ft.

Sand _____

Gas _____

Oil _____

Total Depth _____

PRODUCTION

1st 24 hrs. Nat. _____

1st 24 hrs. after shot _____

Gas _____ Cu. Ft.

Dry Hole _____

Abandoned _____

Date

OCT 4 1939

19

S. J. LEWIS

Scout

Map No. 71 Sec. 13 Twp. 11 R. 17WWell No. 2 CressFrank Hollow

Company

Contractor

COMPLETED

SE NW SW

990 Ft. from N. Line

_____ Ft. from S. Line

_____ Ft. from E. Line

990 Ft. from W. Line**SECTION PLAT**

BEMIS POOL

Location _____

Rig up _____

Drilling and Remarks:

*Core 3366**5 1/2" @ 3367**1500 Acid**Echometer P.S.**2580***RECORD**

Cased _____ in., _____ ft.

Sand _____

Gas _____

Oil _____

Total Depth 3372**PRODUCTION**

1st 24 hrs. Nat. _____

1st 24 hrs. after shot _____

Gas _____ Cu. Ft.

Dry Hole _____

Abandoned _____

Date

NOV 8 1939₁₉S. J. LEWIS

Scout