

# KANSAS

Form 51-5M-7-39-Palace

Ellis


Section 13 Township 11 Range 17-W

Well No. #3 Cress

Company Hollow et al

**Bamis Pool**

NORTH

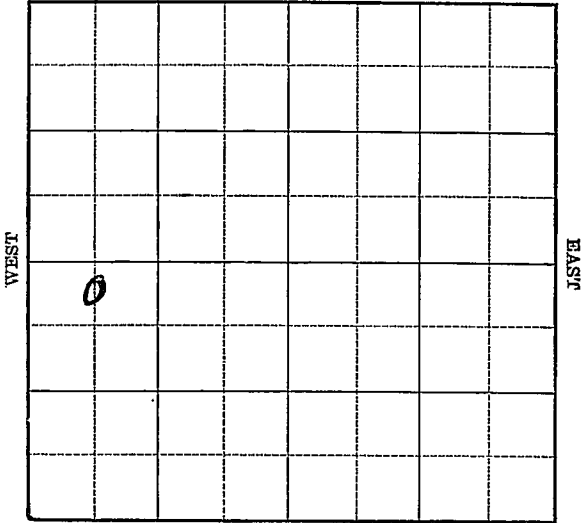

SOUTH

WEST

EAST



Map No. 71 Sec. 13 Twp. 11 R. 17W

Well No. 3 Cress

Hollow etal Company

Contractor

**FIRST REPORT**

C N L NW SW

**SECTION PLAT**

o			

330 Ft. from N. Line

\_\_\_\_\_ Ft. from S. Line

\_\_\_\_\_ Ft. from E. Line

660 Ft. from W. Line

**Bemis Pool**

Location \_\_\_\_\_

Rig up \_\_\_\_\_

Drilling and Remarks:

**Rotary**

**RECORD**

Cased \_\_\_\_\_ in., \_\_\_\_\_ ft.

Sand \_\_\_\_\_

Gas \_\_\_\_\_

Oil \_\_\_\_\_

Total Depth \_\_\_\_\_

**PRODUCTION**

1st 24 hrs. Nat. \_\_\_\_\_

1st 24 hrs. after shot \_\_\_\_\_

Gas \_\_\_\_\_ Cu. Ft.

Dry Hole \_\_\_\_\_

Abandoned \_\_\_\_\_

Date

MAY 8 1940 19

**S. J. LEWIS**

Scout

Map No. 71 Sec. 13 Twp. 11 R. 17WWell No. 3 CressHollow etal

Company

Contractor

**ABANDONED**

C N L NW SW

330 Ft. from N. Line

\_\_\_\_\_ Ft. from S. Line

\_\_\_\_\_ Ft. from E. Line

660 Ft. from W. Line

BEMIS POOL

## SECTION PLAT

o			

Location \_\_\_\_\_

Rig up \_\_\_\_\_

Drilling and Remarks:

*Art 3385**No shows*

## RECORD

Cased \_\_\_\_\_ in., \_\_\_\_\_ ft.

Sand \_\_\_\_\_

Gas \_\_\_\_\_

Oil \_\_\_\_\_

Total Depth 3407

## PRODUCTION

1st 24 hrs. Nat. \_\_\_\_\_

1st 24 hrs. after shot \_\_\_\_\_

Gas \_\_\_\_\_ Cu. Ft.

Dry Hole \_\_\_\_\_

Abandoned \_\_\_\_\_

Date

JUN 5 1940 19

S. J. LEWIS

Scout