

Ellis

KANSAS

Form 51-5M-7-39-Palace

Section 13 Township 11 Range 17-W

Well No. #2 Fred Cress "C"

Company Lario Oil & Gas

NORTH

Bemis Pool

WEST

EAST

0							

SOUTH

13

KANSAS


Ellis

Sec. 13 Twp. 11 R. 17-WWell No. #2 Fred Cress "C" FarmLario Oil & Gas Company

(Bemis)

 Ft. from N. Line990 Ft. from S. Line Ft. from E. Line330 Ft. from W. Line

Elev. 1860

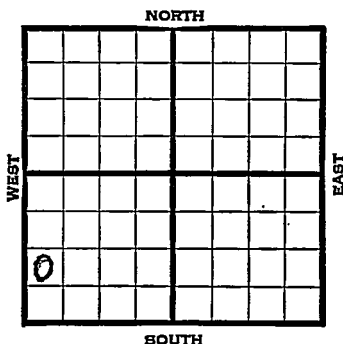

1939	REPORT
8/9	Rotary
8/17	"
8/24	"
8/31	"
9/7	"
9/13	"
9/20	8" - 1060' Anhy 1048'
	Drlg. 1250'
9/28	Drlg. 2900'
10/5	Arb. 3362' 5" - 3362' S.O.
	RUST.
10/11	Arb. 3362'
	5" - 3362'
	T.D. 3377½'
	Echometer potential 9480 bbls.
	Maximum 3500 bbls.
	COMPLETED

Map No. 71 Sec. 13 Twp. 11 R. 17WWell No. 2 Fred Cress "C"Lario Oil & Gas

Company

Contractor

FIRST REPORT

NW SW SW

 Ft. from N. Line990 Ft. from S. Line Ft. from E. Line330 Ft. from W. Line

BEMIS POOL

SECTION PLAT

0			

Location Rig up

Drilling and Remarks:

ROTARY

RECORD

Cased in., ft.Sand Gas Oil Total Depth

PRODUCTION

1st 24 hrs. Nat. 1st 24 hrs. after shot Gas Cu. Ft.Dry Hole Abandoned

Date

AUG 9 1939

19

S. J. LEWIS

Scout

Map No. 71 Sec. 13 Twp. 11 R. 17WWell No. 2 Fred Cress "C"Lario Oil & Gas

Company

Contractor

COMPLETED

SECTION PLAT

NW SW SW

Ft. from N. Line

990 Ft. from S. Line

Ft. from E. Line

330 Ft. from W. Line

BEMIS POOL

0			

Location _____

Rig up _____

Drilling and Remarks: "

*Cir 8 3362**5" @ 3362**Echometers P. Y.**9480**Maximum 3500*

RECORD

Cased _____ in., _____ ft.

Sand _____

Gas _____

Oil _____

Total Depth 33 70 1/2

PRODUCTION

1st 24 hrs. Nat. _____

1st 24 hrs. after shot _____

Gas _____ Cu. Ft.

Dry Hole _____

Abandoned _____

Date

Oct 11 1939 19

S. J. LEWIS

Scout