

KANSAS

Form 51-5M-7-39-Palace

Ellis


Section 13 Township 11 Range 17-W

Well No. #4 F. Cress "C"

Company Lario Oil & Gas

Bemis Pool

NORTH

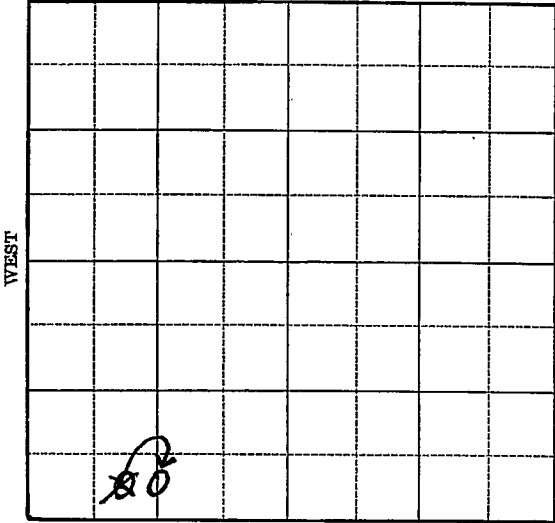

WEST

EAST

SOUTH

Map No. 71 Sec. 13 Twp. 11 R. 17WWell No. 4 F. Cress "C"Lario Oil & Gas

Company

Contractor

FIRST REPORT

SE SW SW

 Ft. from N. Line330 Ft. from S. Line Ft. from E. Line990 Ft. from W. Line

BEMIS POOL

SECTION PLAT

Location XRig up

Drilling and Remarks:

RECORD

Cased in., ft.Sand Gas Oil Total Depth

PRODUCTION

1st 24 hrs. Nat. 1st 24 hrs. after shot Gas Cu. Ft.Dry Hole Abandoned

Date

NOV 2 2 1939

19

S. J. LEWIS

Scout

Ellis

KANSAS

Map No. 71 Sec. 13 Twp. 11 R. 17W

Well No. 4 F. Cross "C"

Lario Oil & Gas Company

CORRECTION Contractor

SECTION PLAT

C S L SW

_____ Ft. from N. Line

330 Ft. from S. Line

_____ Ft. from E. Line

1320 Ft. from W. Line

BEMIS POOL

Location _____

Rig up _____

Drilling and Remarks:

Reported:

SE SW SW

RECORD

Cased _____ in., _____ ft.

Sand _____

Gas _____

Oil _____

Total Depth _____

PRODUCTION

1st 24 hrs. Nat. _____

1st 24 hrs. after shot _____

Gas _____ Cu. Ft.

Dry Hole _____

Abandoned _____

Date

NOV 28 1939

S. J. LEWIS Scout

Map No. 71 Sec. 13 Twp. 11 R. 17W

Well No. 4 F. Cress "C"

Lario Oil & Gas Company

Contractor

COMPLETED

SECTION PLAT

C S L SW

_____ Ft. from N. Line

330 Ft. from S. Line

_____ Ft. from E. Line

1320 Ft. from W. Line

Bemis Pool

Location _____

Rig up _____

Drilling and Remarks:

Core 3376

5" C 3377

5000 Gall

Echometer

9969

Maximum 3000

RECORD

Cased _____ in., _____ ft.

Sand _____

Gas _____

Oil _____

Total Depth 3383

PRODUCTION

1st 24 hrs. Nat. _____

1st 24 hrs. after shot _____

Gas _____ Cu. Ft.

Dry Hole _____

Abandoned _____

Date

DEC 20 1939

S. J. LEWIS Scout