

KANSAS

Ellis


Form 51-5M-7-39-Palace

Section 13 Township 11 Range 17-W

Well No. #5 F. Cress "C"

Company Lario Oil & Gas

Bemis Pool

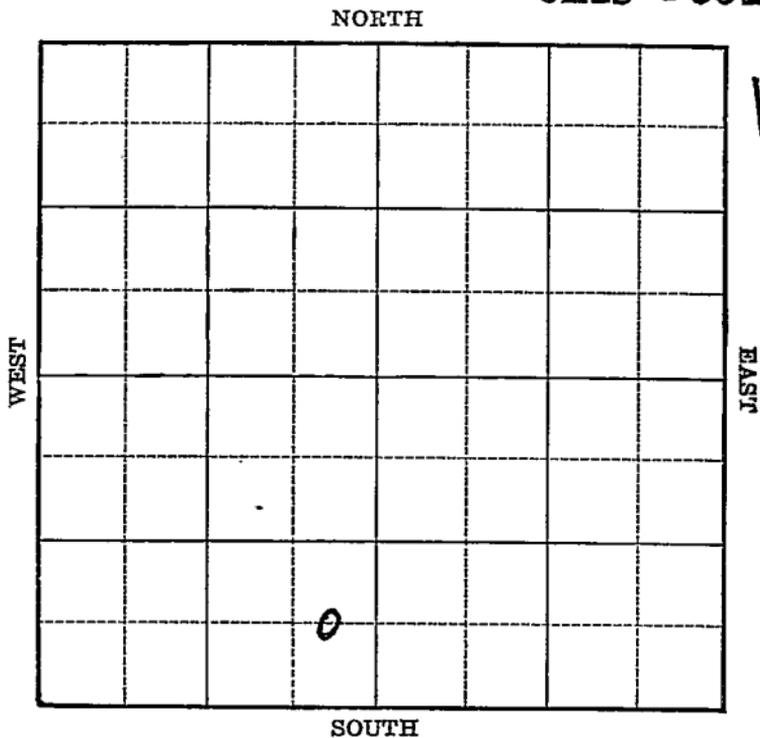

Ellis **KANSAS**Map No. 7/ Sec. 13 Twp. 11 R. 17WWell No. 5 F. Cross "C"Lario Oil & Gas Company

Contractor

FIRST REPORT**C E L S E S W**

_____ Ft. from N. Line

660 Ft. from S. Line330 Ft. from E. Line

_____ Ft. from W. Line

SECTION PLAT

		8	

BEMIS POOLLocation X

Rig up _____

Drilling and Remarks:

RECORD

Cased _____ in., _____ ft.

Sand _____

Gas _____

Oil _____

Total Depth _____

PRODUCTION

1st 24 hrs. Nat. _____

1st 24 hrs. after shot _____

Gas _____ Cu. Ft.

Dry Hole _____

Abandoned _____

Date

MAR 20 1940 19S. J. LEWIS Scout

Map No. 71 Sec. 13 Twp. 11 R. 17W

Well No. 5 F. Cross "C"

Lario Oil & Gas Company

Contractor

COMPLETED
C E L SE SW

SECTION PLAT

 Ft. from N. Line

660 Ft. from S. Line

330 Ft. from E. Line

 Ft. from W. Line

BEMIS POOL

Location

Rig up

Drilling and Remarks:

Cor 83376
5" @ 3377
Echometer P &
4868

Aluminum 3000

RECORD

Cased in., ft.

Sand

Gas

Oil

Total Depth 3380

PRODUCTION

1st 24 hrs. Nat.

1st 24 hrs. after shot

Gas Cu. Ft.

Dry Hole

Abandoned

Date

APR 24 1940 19

S. J. LEWIS Scout