

KANSAS

Ellis

Form 51-5M-7-39-Palace

Section 13 Township 11 Range 17-W

Well No. #3 F. Cress "C"

Company Lario Oil & Gas

Bemis Pool

NORTH

WEST

EAST

SOUTH

	0						

13

Sec. 13 Twp. 11 R. 17-W

Well No. #3 F. Gress "C" Farm

Lario Oil & Gas Company


(Bemis)

 Ft. from N. Line

990 Ft. from S. Line

 Ft. from E. Line

990 Ft. from W. Line

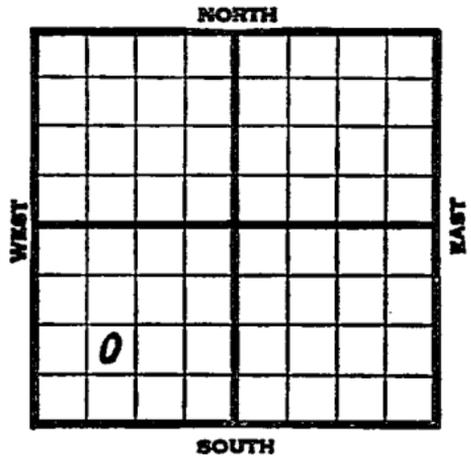

Elev. 1846

1939	REPORT
10/11	Location
10/19	R.O.G.
10/26	"
11/2	"
11/9	Anhy 1035' 8" - 1042' WOC.
11/16	Drlg. 3000'
11/23	Arb. 3350' 5" - 3350'
	Drlg. 3351'
11/28	Arb. 3350'
	5" - 3350'
	T.D. 3357'
	700 acid.
	Echometer potential 5024 bbls.
	Maximum 3500 bbls.
	COMPLETED

Map No. 71 Sec. 13 Twp. 11 R. 17WWell No. 3 F. Cress "C"Lario Oil & Gas

Company

Contractor

FIRST REPORT

NE SW SW

 Ft. from N. Line990 Ft. from S. Line Ft. from E. Line990 Ft. from W. Line

SECTION PLAT

BEMIS POOL

Location XRig up Drilling and Remarks:

RECORD

Cased in., ft.Sand Gas Oil Total Depth

PRODUCTION

1st 24 hrs. Nat. 1st 24 hrs. after shot Gas Cu. Ft.Dry Hole Abandoned

Date

OCT 11 1939

19

S. J. LEWIS

Scout

Map No. 71 Sec. 13 Twp. 11 R. 17WWell No. 3 F. Cross "C"Lario Oil & Gas

Company

Contractor

COMPLETED

SECTION PLAT

NE SW SW

_____ Ft. from N. Line

990 Ft. from S. Line

_____ Ft. from E. Line

990 Ft. from W. Line

BEMIS POOL

Location _____

Rig up _____

Drilling and Remarks:

*Co. & 3350**5" C 3350.**7000 acd**Echometer P. & X**5024**Maximan 3500*

RECORD

Cased _____ in., _____ ft.

Sand _____

Gas _____

Oil _____

Total Depth 3357

PRODUCTION

1st 24 hrs. Nat. _____

1st 24 hrs. after shot _____

Gas _____ Cu. Ft.

Dry Hole _____

Abandoned _____

Date

NOV 28 1939 19S. J. LEWIS Scout