

KANSAS

Form 51-5M-7-39-Palace


Ellis

Section 13 Township 11 Range 17-W

Well No. #3 Pearl

Company Lario Oil & Gas

Bemis Pool

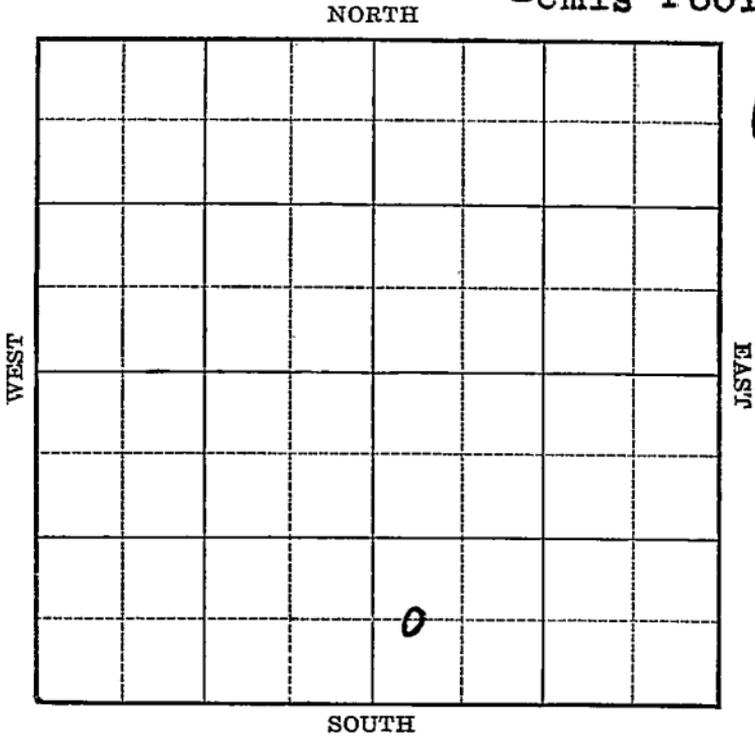

Map No. 71 Sec. 13 Twp. 11 R. 17WWell No. 3 PearlLario Oil & Gas Company

Contractor

FIRST REPORT

C W L SW SE

_____ Ft. from N. Line

660 Ft. from S. Line

_____ Ft. from E. Line

330 Ft. from W. Line

BEMIS POOL

SECTION PLAT

		o	

Location _____

Rig up _____

Drilling and Remarks:

Derrick

RECORD

Cased _____ in., _____ ft.

Sand _____

Gas _____

Oil _____

Total Depth _____

PRODUCTION

1st 24 hrs. Nat. _____

1st 24 hrs. after shot _____

Gas _____ Cu. Ft.

Dry Hole _____

Abandoned _____

Date

APR 17 1940 19S. J. LEWIS Scout

Map No. 71 Sec. 13 Twp. 11 R. 17W

Well No. 3 Pearl

Lario Oil & Gas Company

Contractor

COMPLETED

SECTION PLAT

C W L SW SE

_____ Ft. from N. Line

660 Ft. from S. Line

_____ Ft. from E. Line

330 Ft. from W. Line

		0	

BEMIS POOL

Location _____

Rig up _____

Drilling and Remarks:

Cor 83390
5" C 83391
500 acid
Depthograph Pt.
36.47
Maximum 3000

RECORD

Cased _____ in., _____ ft.

Sand _____

Gas _____

Oil _____

Total Depth 3394

PRODUCTION

1st 24 hrs. Nat. _____

1st 24 hrs. after shot _____

Gas _____ Cu. Ft.

Dry Hole _____

Abandoned _____

Date

MAY 15 1940 19

S. J. LEWIS Scout