

KANSAS


Ellis

Form 51-5M-7-39-Palace

Section 13 Township 11 Range 17-W

Well No. #4 Pearl

Company Lario Oil & Gas

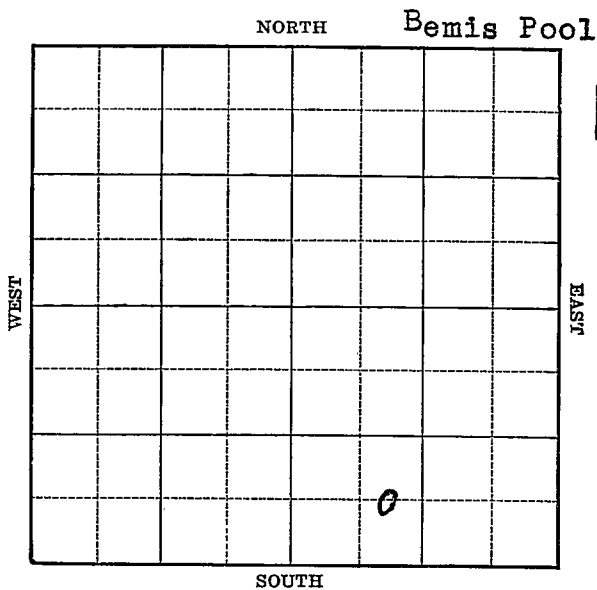

Sec. 13 Twp. 11 R. 17-W

Well No. #4 Pearl Farm

Lario Oil & Gas Company

(Bemis)


_____ Ft. from N. Line

660 Ft. from S. Line

_____ Ft. from E. Line

990 Ft. from W. Line

Elev. 1875

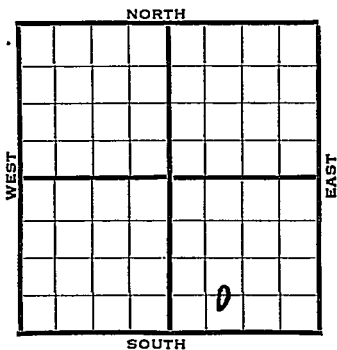

1940	REPORT
4/24	Rotary.
5/2	Wait on tools.
5/9	" " "
5/16	12" - 54' Drlg. 750'
5/23	8" - 1082' Drlg. 2200'
5/29	Drlg. 2843'
6/6	Arb. 3374' T.D. 3376'
	5" - 3374' RUST.
6/12	Arb. 3374'
	5" - 3374'
	T.D. 3378'
	1500 acid.
	Echometer potential 4995 bbls.
	Maximum 3000 bbls.
	COMPLETED

Map No. 71 Sec. 13 Twp. 11 R. 17WWell No. 4 Pearl

Lario Oil & Gas

Company

Contractor

FIRST REPORT

SECTION PLAT

C E L SW SE

_____ Ft. from N. Line

660 Ft. from S. Line

_____ Ft. from E. Line

990 Ft. from W. Line

BEMIS POOL

Location _____

Rig up _____

Drilling and Remarks:
rotary

RECORD

Cased _____ in., _____ ft.

Sand _____

Gas _____

Oil _____

Total Depth _____

PRODUCTION

1st 24 hrs. Nat. _____

1st 24 hrs. after shot _____

Gas _____ Cu. Ft.

Dry Hole _____

Abandoned _____

Date

APR 24 1940

19

S. J. LEWIS Scout

