

# KANSAS

Form 51-5M-7-39-Palace


Ellis

Section 13 Township 11 Range 17-W

Well No. #2 Pearl

Company Lario Oil & Gas

NORTH Bemis Pool

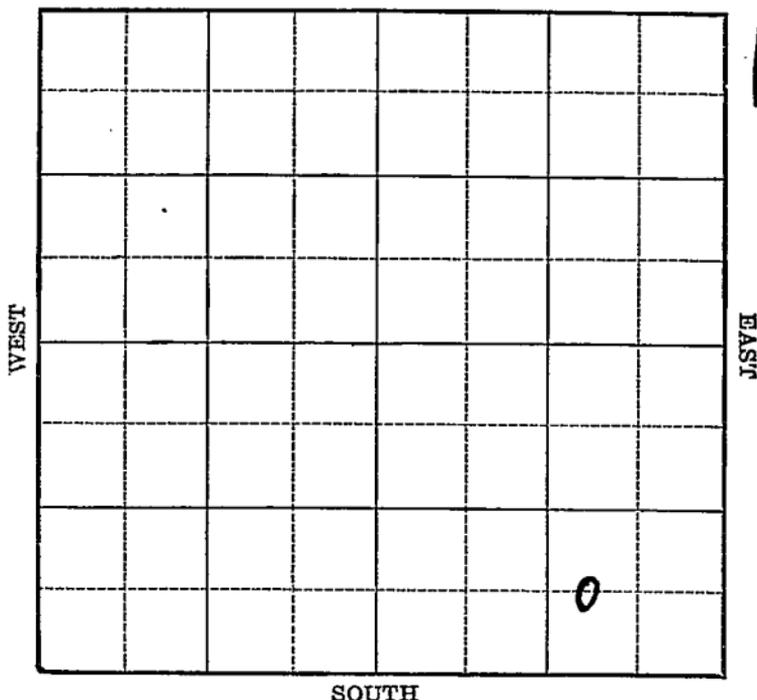

Sec. 13 Twp. 11 R. 17-W

Well No. #2 Pearl Farm

Lario Oil & Gas Company

(Bemis)


\_\_\_\_\_ Ft. from N. Line

660 Ft. from S. Line

990 Ft. from E. Line

\_\_\_\_\_ Ft. from W. Line

Elev. 1879

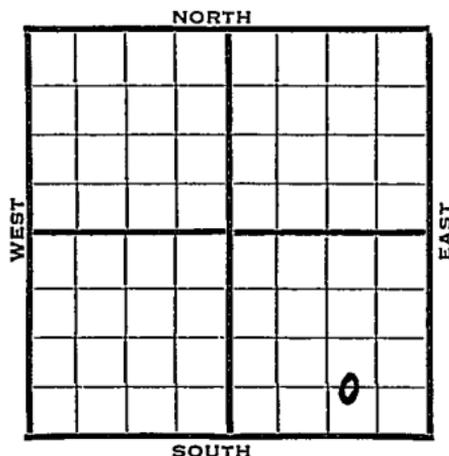

	REPORT
1940	
3/27	Derrick.
4/4	"
4/12	"
4/18	Anhy 1065' 8" - 1077'
	Drlg. 2300'
4/25	Drlg. 3310'
5/2	Arb. 3389' 5" - 3390'
	T.D. 3396' 1700' oil 2 hours.
	1000 acid.
5/8	Arb. 3389
	5" 3390'
	Total Depth 3396'
	1500 acid
	Depthograph potential 4839
	Maximum 3000
	<b>COMPLETED</b>

Map No. 7 Sec. 13 Twp. 11 R. 17WWell No. 2 PearlLario Oil & Gas Company

Contractor

## FIRST REPORT

C W L SE SE

\_\_\_\_\_ Ft. from N. Line

660 Ft. from S. Line990 Ft. from E. Line

\_\_\_\_\_ Ft. from W. Line

BEMIS POOL

## SECTION PLAT

			0

Location \_\_\_\_\_

Rig up \_\_\_\_\_

Drilling and Remarks:

Derrick

## RECORD

Cased \_\_\_\_\_ in., \_\_\_\_\_ ft.

Sand \_\_\_\_\_

Gas \_\_\_\_\_

Oil \_\_\_\_\_

Total Depth \_\_\_\_\_

## PRODUCTION

1st 24 hrs. Nat. \_\_\_\_\_

1st 24 hrs. after shot \_\_\_\_\_

Gas \_\_\_\_\_ Cu. Ft.

Dry Hole \_\_\_\_\_

Abandoned \_\_\_\_\_

Date

MAR 27 1940 19

S. J. LEWIS Scout

Map No. 71 Sec. 13 Twp. 11 R. 17W

Well No. 2 Pearl

Lario Oil & Gas Company

Contractor

**COMPLETED**

**SECTION PLAT**

**C W L SE SE**

			0

\_\_\_\_\_ Ft. from N. Line

660 Ft. from S. Line

990 Ft. from E. Line

\_\_\_\_\_ Ft. from W. Line

**BEMIS POOL**

Location \_\_\_\_\_

Rig up \_\_\_\_\_

Drilling and Remarks:

*See # 3389*

*5" C 3390*

*1500 cu. ft.*

*Depthograph 88'*

*4839*

*Maximum 3000*

**RECORD**

Cased \_\_\_\_\_ in., \_\_\_\_\_ ft.

Sand \_\_\_\_\_

Gas \_\_\_\_\_

Oil \_\_\_\_\_

Total Depth 3396

**PRODUCTION**

1st 24 hrs. Nat. \_\_\_\_\_

1st 24 hrs. after shot \_\_\_\_\_

Gas \_\_\_\_\_ Cu. Ft.

Dry Hole \_\_\_\_\_

Abandoned \_\_\_\_\_

Date

MAY 8 1940 19

S. J. LEWIS Scout