


KANSAS

FORM 51 5M 4-41 PETROL **Ellis**

Section 14 Township 11 Range 18W

Well No. 1 Deane

Company Shell

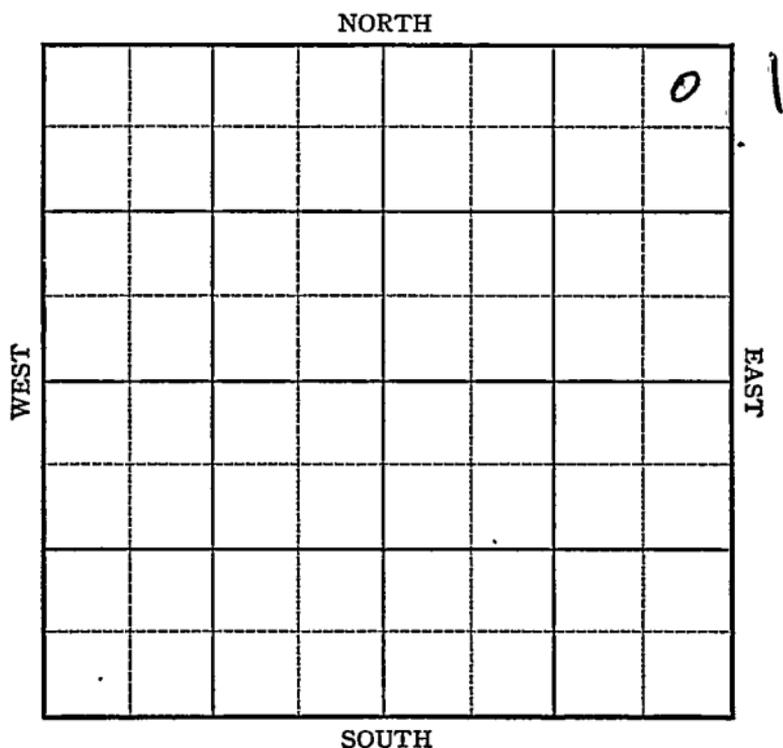

Sec. 14 Twp. 11 R. 18-W

Well No. #1 Deane Farm _____

Shell Company _____

(Burnett)


330 Ft. from N. Line

_____ Ft. from S. Line

330 Ft. from E. Line

_____ Ft. from W. Line

Elev. 1863

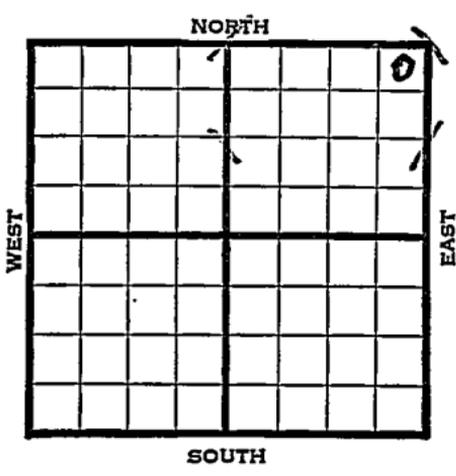

1941	REPORT
6/4	Rotary.
6/12	13" - 74' 8" - 1130'
	Drlg. 2090'
6/16	Drlg. 3200'
6/26	Arb. 3356' 4" - 3357'
	T.D. 3358' RUST.
7/3	T.D. 3368' 500 acid.
	Swab 22 oil 3 hours.
7/9	Arb. 3356'
	4" - 3357'
	T.D. 3368'
	500 acid.
	Depthograph potential 58,351 bbl
	Maximum 3000 bbls.
	32. Gravity
	COMPLETED

Map No. _____ Sec. 14 Twp. 11 R. 18WWell No. 1 DeaneShell

Company

Contractor

FIRST REPORT

NE/C

330 Ft. from N. Line

_____ Ft. from S. Line

330 Ft. from E. Line

_____ Ft. from W. Line

BURNETT POOL

SECTION PLAT

Location _____

Rig up _____

Drilling and Remarks:

Rotary

RECORD

Cased _____ in., _____ ft.

Sand _____

Gas _____

Oil _____

Total Depth _____

PRODUCTION

1st 24 hrs. Nat. _____

1st 24 hrs. after shot _____

Gas _____ Cu. Ft.

Dry Hole _____

Abandoned _____

Date

JUN 4 1941 19

S. J. LEWIS Scout

Map No. _____ Sec. 14 Twp. 11 R. 18WWell No. 1 DeaneShell

Company

~~COMPLETED~~

Contractor

SECTION PLAT

NE/C

330 Ft. from N. Line

_____ Ft. from S. Line

330 Ft. from E. Line

_____ Ft. from W. Line

			0

BURNETT POOL

Location _____

Rig up _____

Drilling and Remarks:

Cor Y 3356
4" O 3357
500 acid
Depth to Y 58357
Max 3000
32 e Gr

RECORD

Cased _____ in., _____ ft.

Sand _____

Gas _____

Oil _____

Total Depth 3368

PRODUCTION

1st 24 hrs. Nat. _____

1st 24 hrs. after shot _____

Gas _____ Cu. Ft.

Dry Hole _____

Abandoned _____

Date

JUL 9 1941 19 _____ S. J. LEWIS Scout