

Ellis


FORM 51 5M 4-41 PETROL

KANSAS

Section 14 Township 11 Range 18W

Well No. 2 Deane

Company Shell

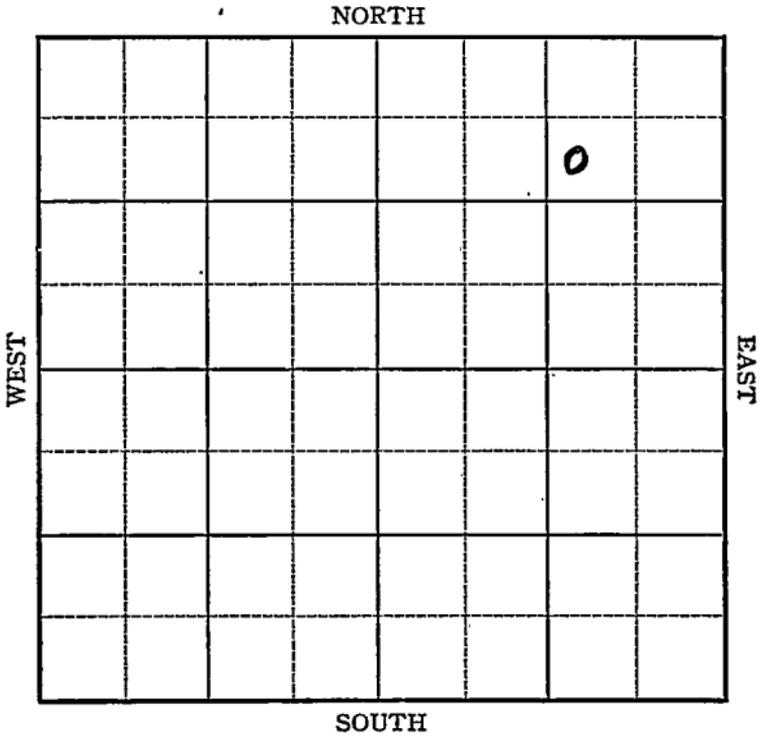

Sec. 14 Twp. 11 R. 18-W

Well No. #2 Deane Farm
Shell Company

(Burnett)


974 Ft. from N. Line

_____ Ft. from S. Line

1013 Ft. from E. Line

_____ Ft. from W. Line

Elev. 1867

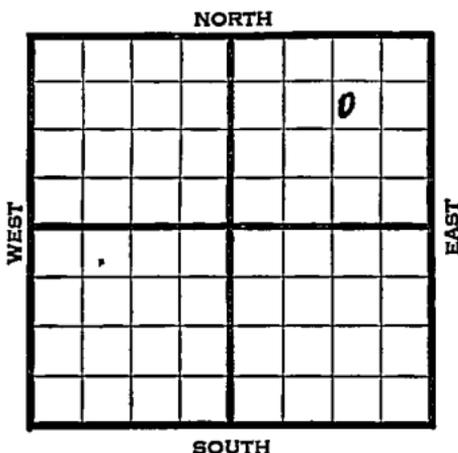

1941	REPORT
7/16	Rotary.
7/24	13" @ 791 Drlg. 510
7/31	8" @ 1130'
	Topeka 3816'
	Drl g. 2960'
8/7	Soov. 3326 Arb 3365-67 TD
	4" @ 3366 RUST
8/13	Arb. 3365'
	4" - 3366'
	500 acid
	T.D. 3375'
	Swb. 163 oil 2 hrs
	Deptho pot. 29,112
	Grav. 32.
	COMPLETED

Map No. 71 Sec. 14 Twp. 11 R. 18WWell No. 2 DeaneShell

Company

Contractor

FIRST REPORT

SW NE NE

974 Ft. from N. Line


_____ Ft. from S. Line

1013 Ft. from E. Line

_____ Ft. from W. Line

BURNETT POOL

SECTION PLAT

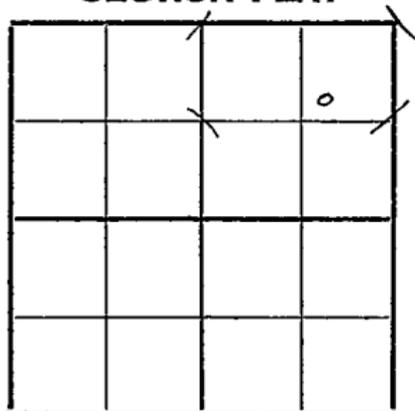

Location _____

Rig up _____

Drilling and Remarks:

Rotary

RECORD

Cased _____ in., _____ ft.

Sand _____

Gas _____

Oil _____

Total Depth _____

PRODUCTION

1st 24 hrs. Nat. _____

1st 24 hrs. after shot _____

Gas _____ Cu. Ft.

Dry Hole _____

Abandoned _____

Date

III 1 6 1941 19S. J. LEWIS Scout

Map No. 71 Sec. 14 Twp. 11 R. 18W

Well No. 2 Deane
Shell

_____ Company

_____ Contractor

974 SW NE NE
Ft. from N. Line


_____ Ft. from S. Line

1013 Ft. from E. Line

_____ Ft. from W. Line

BURNETT POOL

SECTION PLAT

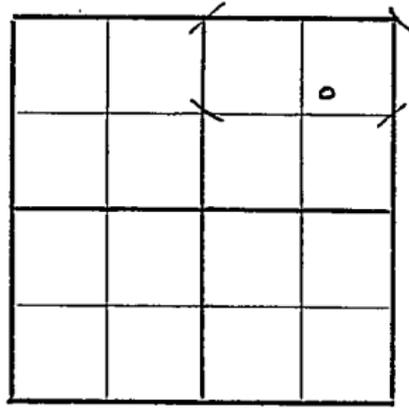

Location _____

Rig up _____

Drilling and Remarks:

arb 3365
4" 336.6
500 acid
sub 163 oil 2 hrs.
Depth Pot. 29,112
COMPLETED

RECORD

Cased _____ in., _____ ft.

Sand _____

Gas _____

Oil _____

Total Depth 3375

PRODUCTION

1st 24 hrs. Nat. _____

1st 24 hrs. after shot _____

Gas _____ Cu. Ft.

Dry Hole _____

Abandoned _____

Date

AUG 13 1941 19

S. J. LEWIS Scout

329aw