

Section 14 Township 11 Range 18W

Well No. #1 Conrad

Company Lario Oil & Gas

Burnett

NORTH

4

WEST

EAST

| | | | | | | | |
|---|--|--|--|--|--|--|--|
| o | | | | | | | |
| | | | | | | | |
| | | | | | | | |
| | | | | | | | |
| | | | | | | | |
| | | | | | | | |
| | | | | | | | |
| | | | | | | | |

SOUTH

KANSAS

Ellis

Sec. 14 Twp. 11 R. 18-W

Well No. 1 Conrad Farm

Lario Oil and Gas Company

Burnett Pool


330' Ft. from N. Line

Ft. from S. Line

Ft. from E. Line

330' Ft. from W. Line

NW/C

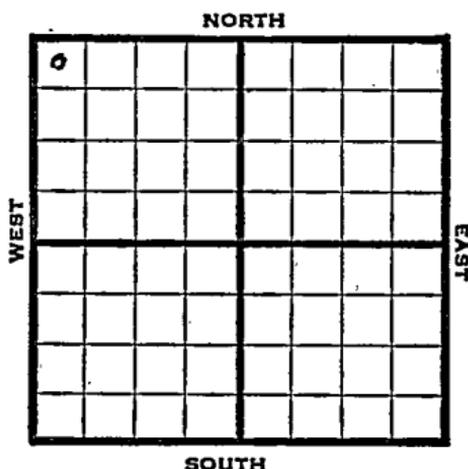

1947 Elev. 1882 REPORT

10/29 Loc.

11/5 RUR

11/12 8" @ 1188'
DrLg. 1325'

11/25 Lansing 3128
Arbuckle 3473
TD 3526

ABANDONED

Map No. _____ Sec. 14 Twp. 11 R. 18W

Well No. 1 Conrad

Lario Oil and Gas Company

FIRST REPORT Contractor

NW/C

SECTION PLAT

330 Ft. from N. Line

_____ Ft. from S. Line

_____ Ft. from E. Line

330 Ft. from W. Line

| | | | |
|---|--|--|--|
| 0 | | | |
| | | | |
| | | | |
| | | | |
| | | | |


Location X

Rig up _____

Drilling and Remarks:

RECORD

Cased _____ in., _____ ft.

Sand _____

Gas _____

Oil _____

Total Depth _____

PRODUCTION

1st 24 hrs. Nat. _____

1st 24 hrs. after shot _____

Gas _____ Cu. Ft.

Dry Hole _____

Abandoned _____

Date

OCT 29 1947

19

S. J. LEWIS

Scout

