


Section 14 Township 11 Range 18-W

Well No. #1 Lynn

Company Central Petr. et al

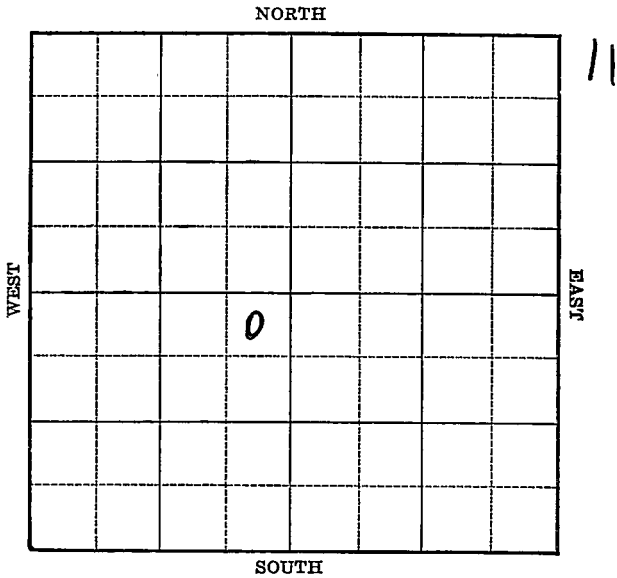

Map No. 71 Sec. 14 Twp. 11 R. 18WWell No. 1 LynnCentral Petroleum et al Company

Contractor

FIRST REPORT

NE SW

330 Ft. from N. Line

_____ Ft. from S. Line

330 Ft. from E. Line

_____ Ft. from W. Line

BURNETT POOL

SECTION PLAT

Location _____

Rig up _____

Drilling and Remarks:
Rotary

RECORD

Cased _____ in., _____ ft.

Sand _____

Gas _____

Oil _____

Total Depth _____

PRODUCTION

1st 24 hrs. Nat. _____

1st 24 hrs. after shot _____

Gas _____ Cu. Ft.

Dry Hole _____

Abandoned _____

Date

APR 3 1940 19

S. J. LEWIS Scout

Map No. 71 Sec. 14 Twp. 11 R. 18WWell No. 1 LynnCentral Petroleum et al Company

Contractor

ABANDONED

SECTION PLAT

NE SW


330 Ft. from N. Line

_____ Ft. from S. Line

330 Ft. from E. Line

_____ Ft. from W. Line

BURNETT POOL

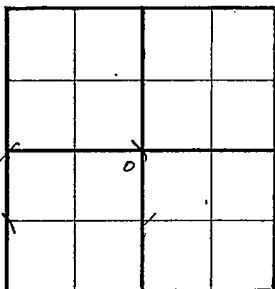

Location _____

Rig up _____

Drilling and Remarks:

*Cr 83450**Water*

RECORD

Cased _____ in., _____ ft.

Sand _____

Gas _____

Oil _____

Total Depth 3474

PRODUCTION

1st 24 hrs. Nat. _____

1st 24 hrs. after shot _____

Gas _____ Cu. Ft.

Dry Hole _____

Abandoned _____

Date

APR 24 1940 19

S. J. LEWIS Scout